



PRE-PLANNING REAR ELEVATION

GENERAL NOTES:

Do not scale: use given dimensions only. All setting out to be verified on site and any discrepancies notified to the Architect.

NOTES

0 2m 4m 6m 8m 10m

rev.	date	by	description	

DATE	JUNE 2021	
SCALE	1:50 @ A3 1:100 @ A4	
DRAWN BY	EA	


STATUS	PLANNING	
DRAWING	PRE-PLANNING REAR ELEVATION	DWG NO. 101 REV.
CLIENT	MR M RUFFELL	

PROJECT	100 INGREBOURNE GARDENS UPMINSTER RM14 1BW	JOB NO. 493
---------	---	----------------

bla architects

ARCHITECTURE • INTERIOR DESIGN • PROJECT MANAGEMENT

Studio 6, Rosebery House, 70 Rosebery Avenue London EC1R 4RR
tel: 0207 278 1945 mail@bla-architects.com www.bla-architects.com

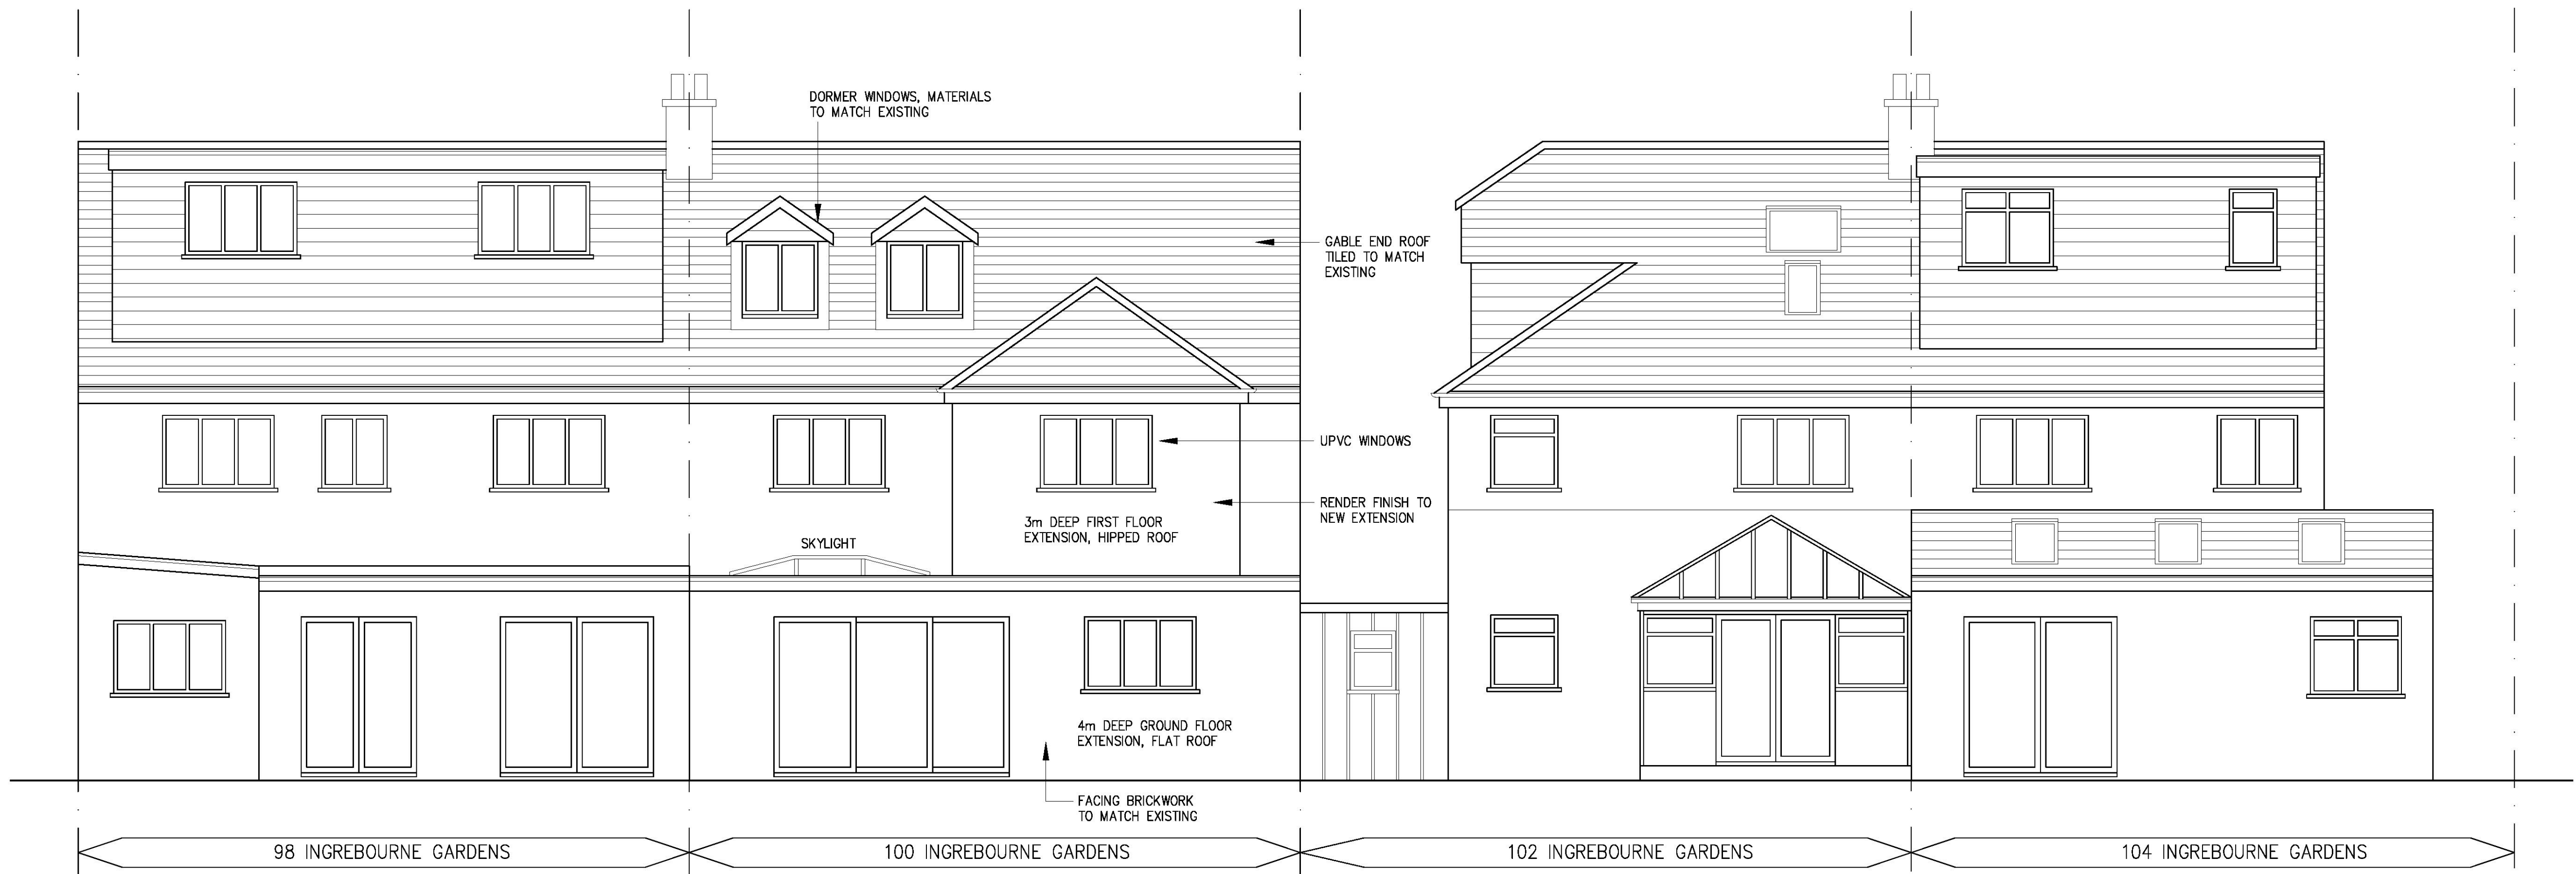

APPROVED PLANNING REAR ELEVATION

GENERAL NOTES:

Do not scale: use given dimensions only. All setting out to be verified on site and any discrepancies notified to the Architect.

NOTES

rev.	date	by	description

DATE	JUNE 2021
SCALE	1:50 @ A3 1:100 @ A4
DRAWN BY	EA

STATUS	PLANNING
DRAWING	APPROVED PLANNING REAR ELEVATION
CLIENT	MR M RUFFELL

DWG NO.	102
REV.	

PROJECT

100 INGREBOURNE GARDENS
UPMINSTER RM14 1BW

JOB NO.

493

bla architects

ARCHITECTURE • INTERIOR DESIGN • PROJECT MANAGEMENT

Studio 6, Rosebery House, 70 Rosebery Avenue London EC1R 4RR
tel: 0207 278 1945 mail@bla-architects.com www.bla-architects.com



AS BUILT REAR ELEVATION

DIFFERENCE BETWEEN PLANNING AND AS BUILT

- 1. ONE LARGE DORMER INSTEAD OF TWO SMALL DORMERS
- 2. FIRST FLOOR EXTENSION WITH GABLE END INSTEAD OF HIPPED ROOF
- 3. WINDOW AND SLIDING DOORS IN OPPOSITE LOCATIONS

GENERAL NOTES:

Do not scale: use given dimensions only. All setting out to be verified on site and any discrepancies notified to the Architect.

NOTES

0 2m 4m 6m 8m 10m

rev.	date	by	description

DATE

JUNE 2021

SCALE

1:50 @ A3

1:100 @ A4

DRAWN BY

EA

STATUS

PLANNING

DRAWING

PROPOSED RETROSPECTIVE PLANNING REAR ELEVATION

CLIENT

MR M RUFFELL

DWG NO.

103

REV.

PROJECT

100 INGEBOURNE GARDENS
UPMINSTER RM14 1BW

JOB NO.


493

bla architects

ARCHITECTURE • INTERIOR DESIGN • PROJECT MANAGEMENT


Studio 6, Rosebery House, 70 Rosebery Avenue London EC1R 4RR
tel: 0207 278 1945 mail@bla-architects.com www.bla-architects.com

© Copyright Reserved

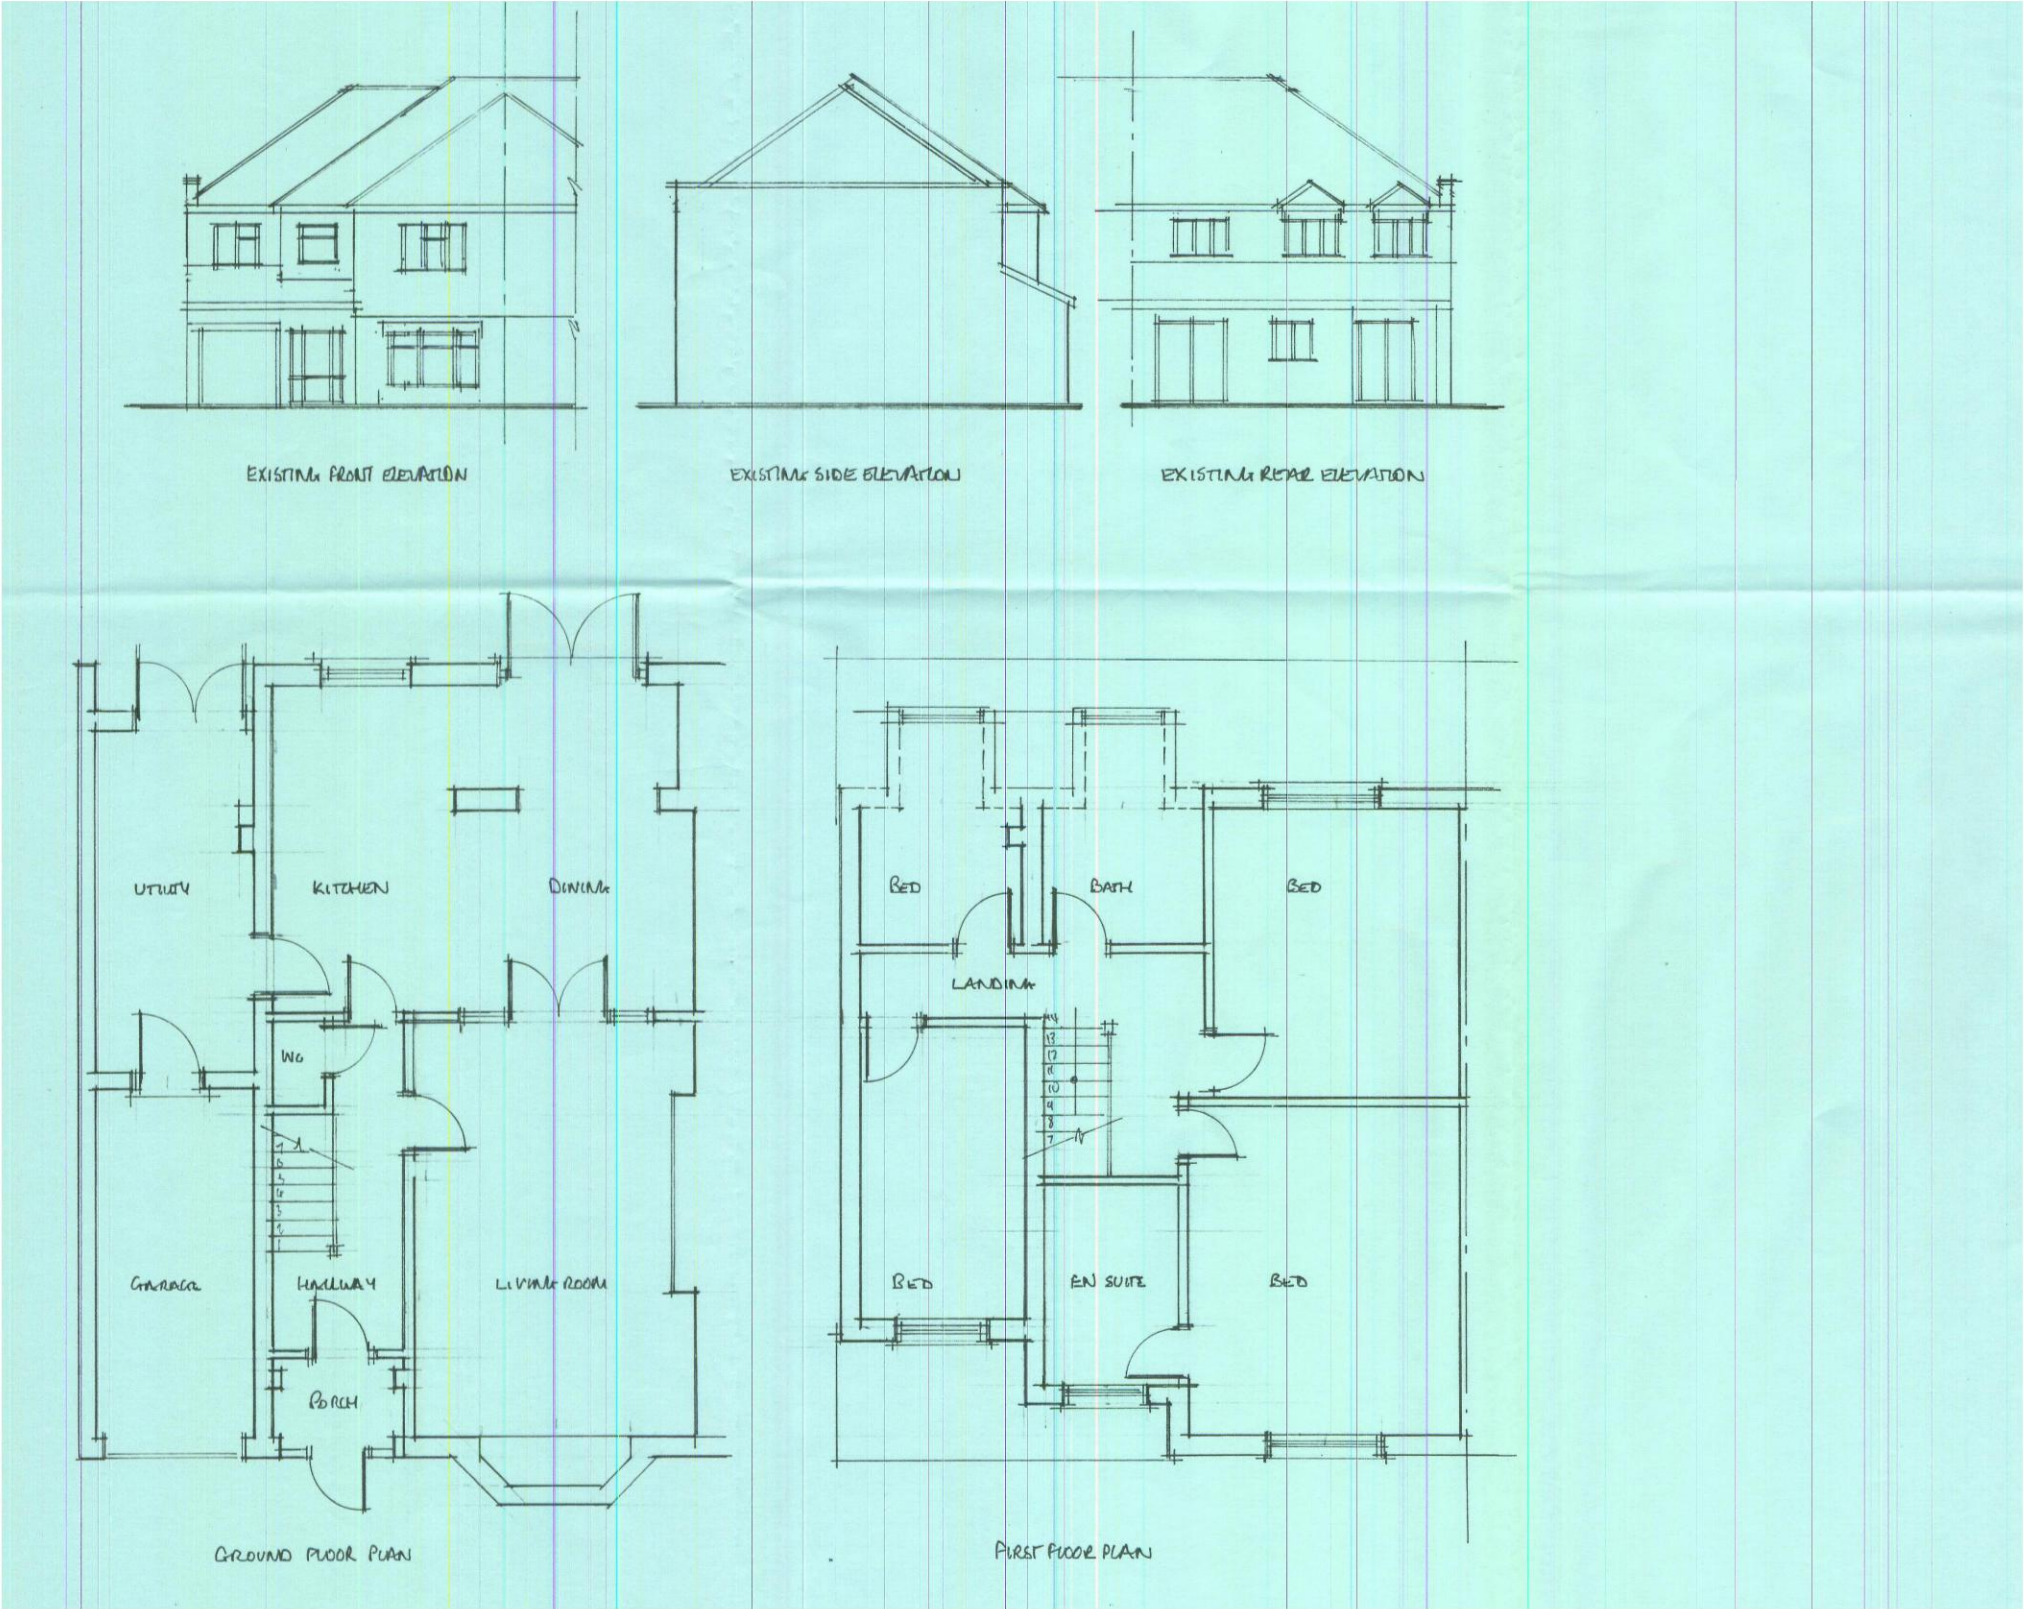

GENERAL NOTES:
Do not scale: use given dimensions only. All setting out to be
verified on site and any discrepancies notified to the Architect.

NOTES

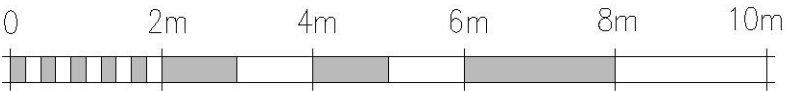

rev.	date	by	description
------	------	----	-------------

DATE	JUNE 2021
------	-----------

STATUS	PLANNING
--------	----------

SCALE	1:50 @ A3 1:100 @ A4
-------	-------------------------

DRAWING	EXISTING (PRE-APPROVED) PLANS & ELEVATIONS
---------	---

DWG NO.	104
REV.	

DRAWN BY	EA
----------	----

CLIENT	MR M RUFFELL
--------	--------------

bla architects
ARCHITECTURE • INTERIOR DESIGN • PROJECT MANAGEMENT
Studio 6, Rosebery House, 70 Rosebery Avenue London EC1R 4RR
tel: 0207 278 1945 mail@bla-architects.com www.bla-architects.com

PROJECT	100 VIGREBOURNE GARDENS UPM VSTER 3M14 13W
---------	---

JOB NO.	493
---------	-----