



PRE-EXISTING REAR ELEVATION

GENERAL NOTES:
Do not scale; use given dimensions only. All setting out to be verified on site and any discrepancies notified to the Architect.

NOTES




rev.	date	by	description

DATE JUNE 2021
SCALE 1:50 @ A3 1:100 @ A4
DRAWN BY EA

STATUS PLANNING	
DRAWING PRE-EXISTING REAR ELEVATION	DWG NO. 101 REV.
CLIENT MR M RUFFELL	


bla architects ARCHITECTURE • INTERIOR DESIGN • PROJECT MANAGEMENT Studio 6, Rosebery House, 70 Rosebery Avenue London EC1R 4RR tel: 0207 278 1945 mail@bla-architects.com www.bla-architects.com	
PROJECT 100 INGREBOURNE GARDENS UPMINSTER RM14 1BW	JOB NO. 493

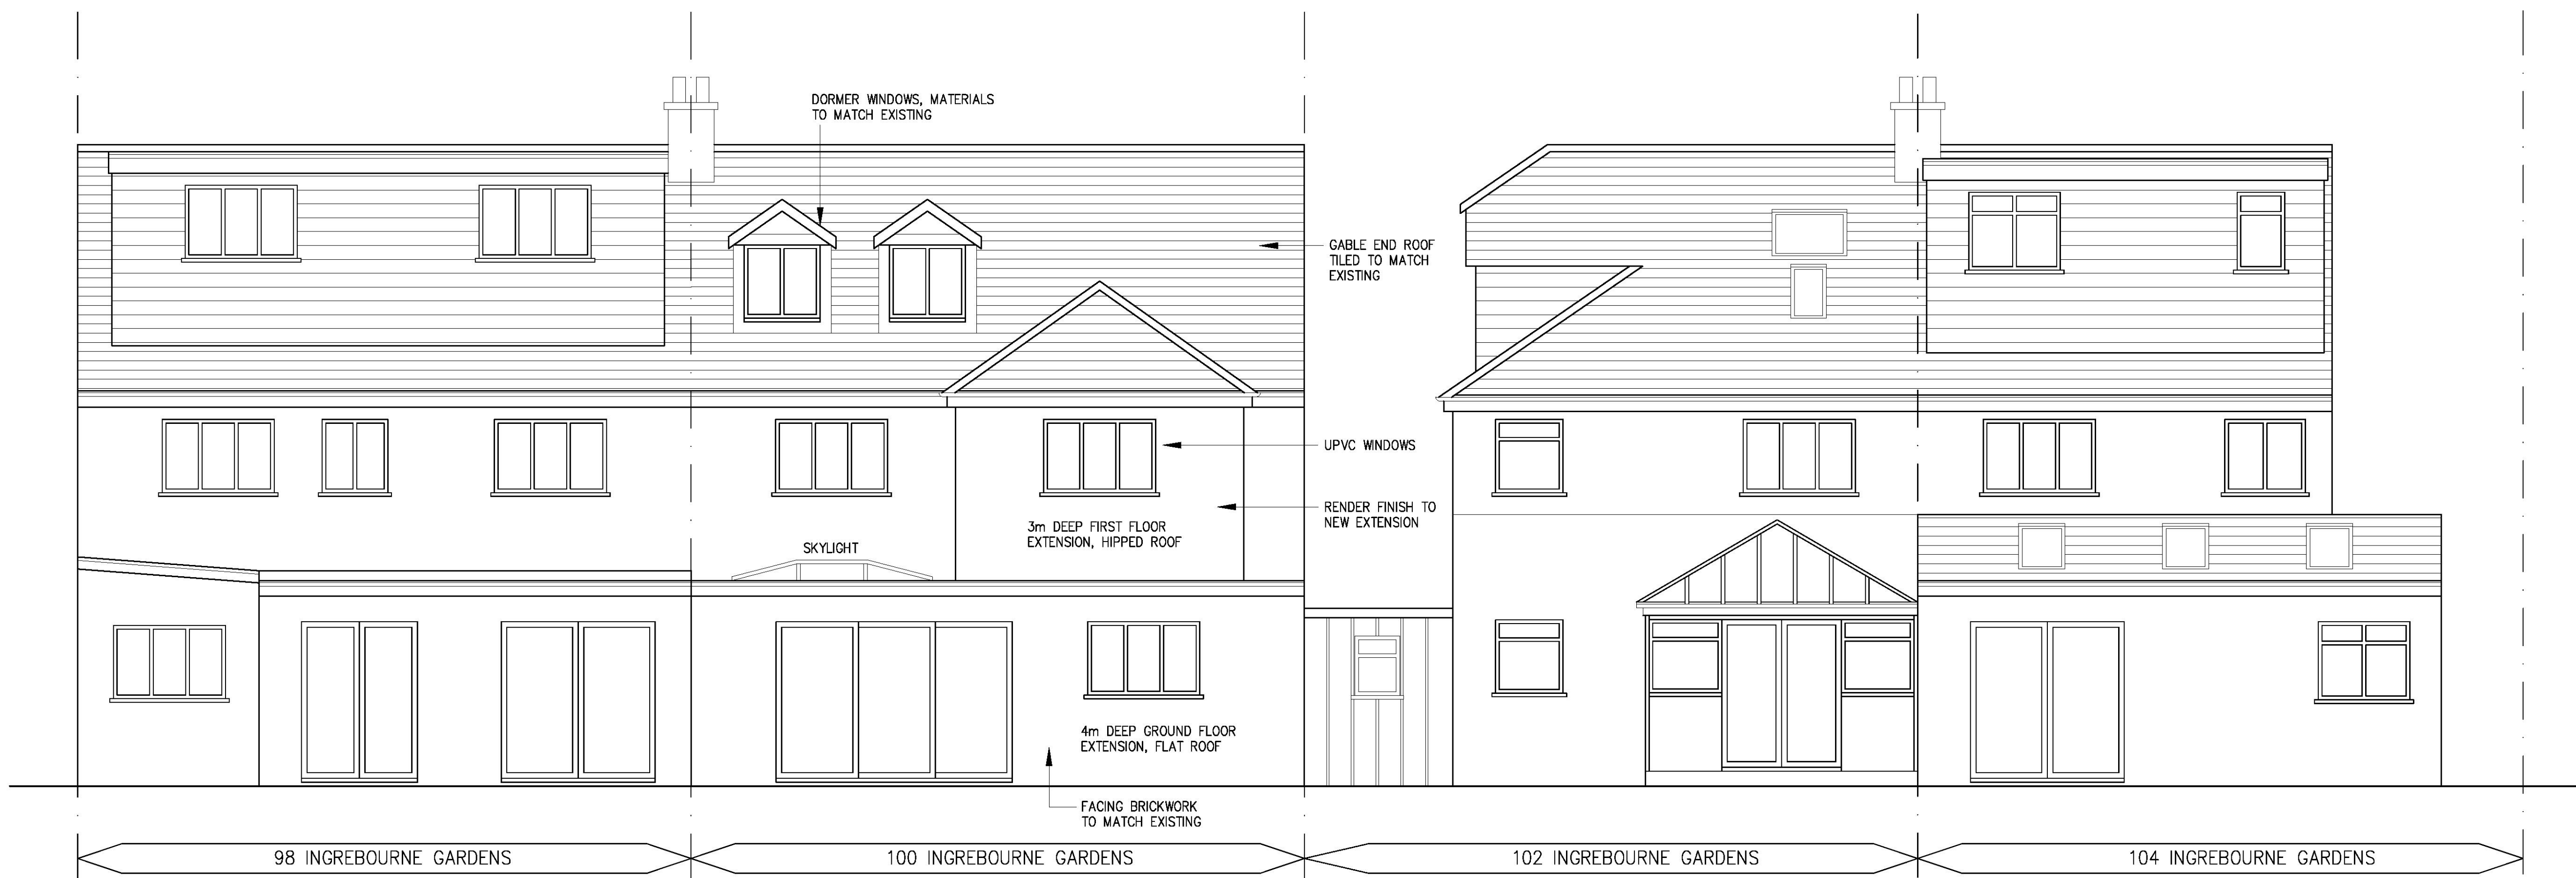

REAR ELEVATION
(approved under application P1815.15)

GENERAL NOTES:
Do not scale; use given dimensions only. All setting out to be verified on site and any discrepancies notified to the Architect.

NOTES

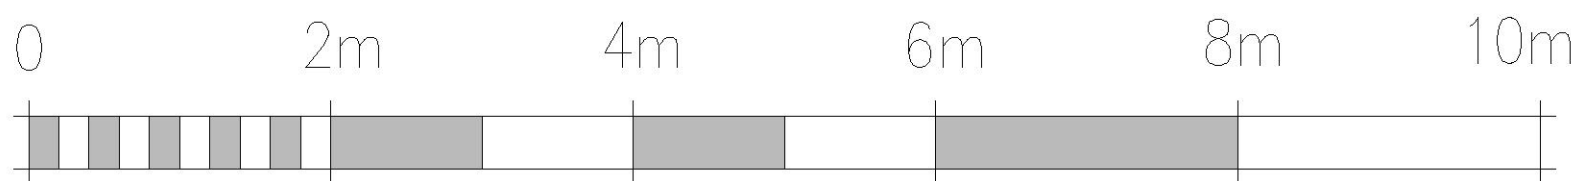

rev.	date	by	description

DATE JUNE 2021
SCALE 1:50 @ A3 1:100 @ A4
DRAWN BY EA

STATUS PLANNING	
DRAWING REAR ELEVATION (approved under application P1815.15)	DWG NO. 102 REV.
CLIENT MR M RUFFELL	

bla architects ARCHITECTURE • INTERIOR DESIGN • PROJECT MANAGEMENT Studio 6, Rosebery House, 70 Rosebery Avenue London EC1R 4RR tel: 0207 278 1945 mail@bla-architects.com www.bla-architects.com	
PROJECT 100 INGREBOURNE GARDENS UPMINSTER RM14 1BW	JOB NO. 493




REAR ELEVATION – AS BUILT

DIFFERENCE BETWEEN PLANNING AND AS BUILT

- 1. ONE LARGE DORMER INSTEAD OF TWO SMALL DORMERS
- 2. FIRST FLOOR EXTENSION WITH GABLE END INSTEAD OF HIPPED ROOF
- 3. WINDOW AND SLIDING DOORS IN OPPOSITE LOCATIONS

GENERAL NOTES:
Do not scale; use given dimensions only. All setting out to be verified on site and any discrepancies notified to the Architect.

NOTES

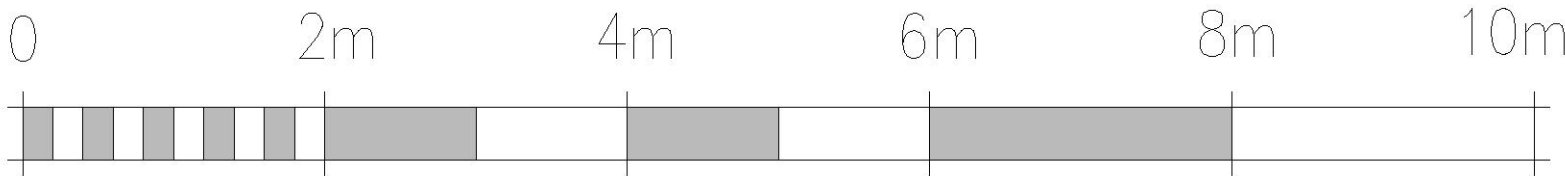

rev.	date	by	description


DATE JUNE 2021
SCALE 1:50 @ A3 1:100 @ A4
DRAWN BY EA

STATUS PLANNING	
DRAWING REAR ELEVATION AS BUILT	DWG NO. 103 REV.
CLIENT MR M RUFFELL	

bla architects ARCHITECTURE • INTERIOR DESIGN • PROJECT MANAGEMENT Studio 6, Rosebery House, 70 Rosebery Avenue London EC1R 4RR tel: 0207 278 1945 mail@bla-architects.com www.bla-architects.com	
PROJECT 100 INGEBOURNE GARDENS UPMINSTER RM14 1BW	JOB NO. 493




EXISTING FRONT ELEVATION

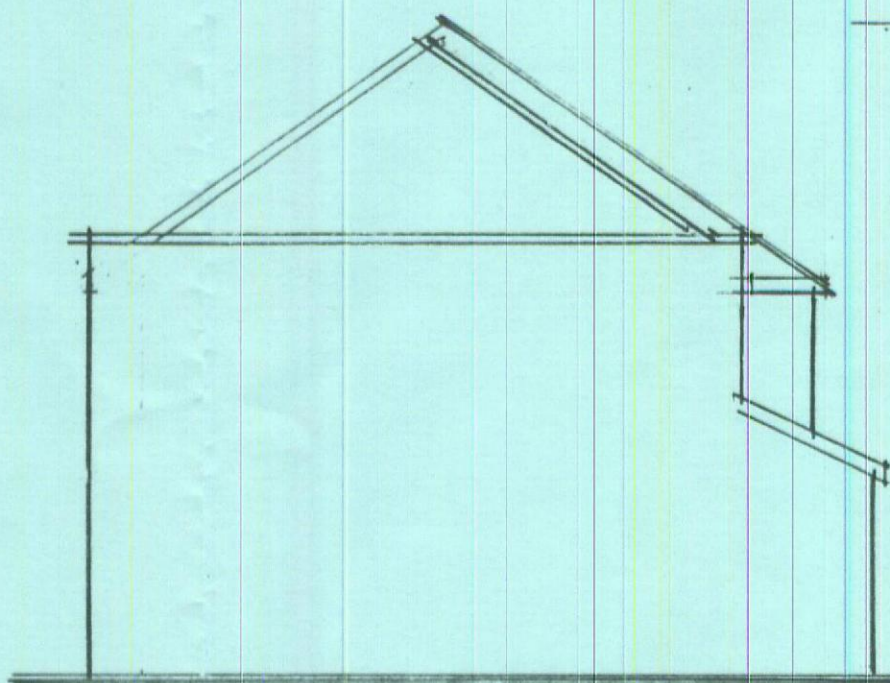


EXISTING SIDE ELEVATION







EXISTING REAR ELEVATION

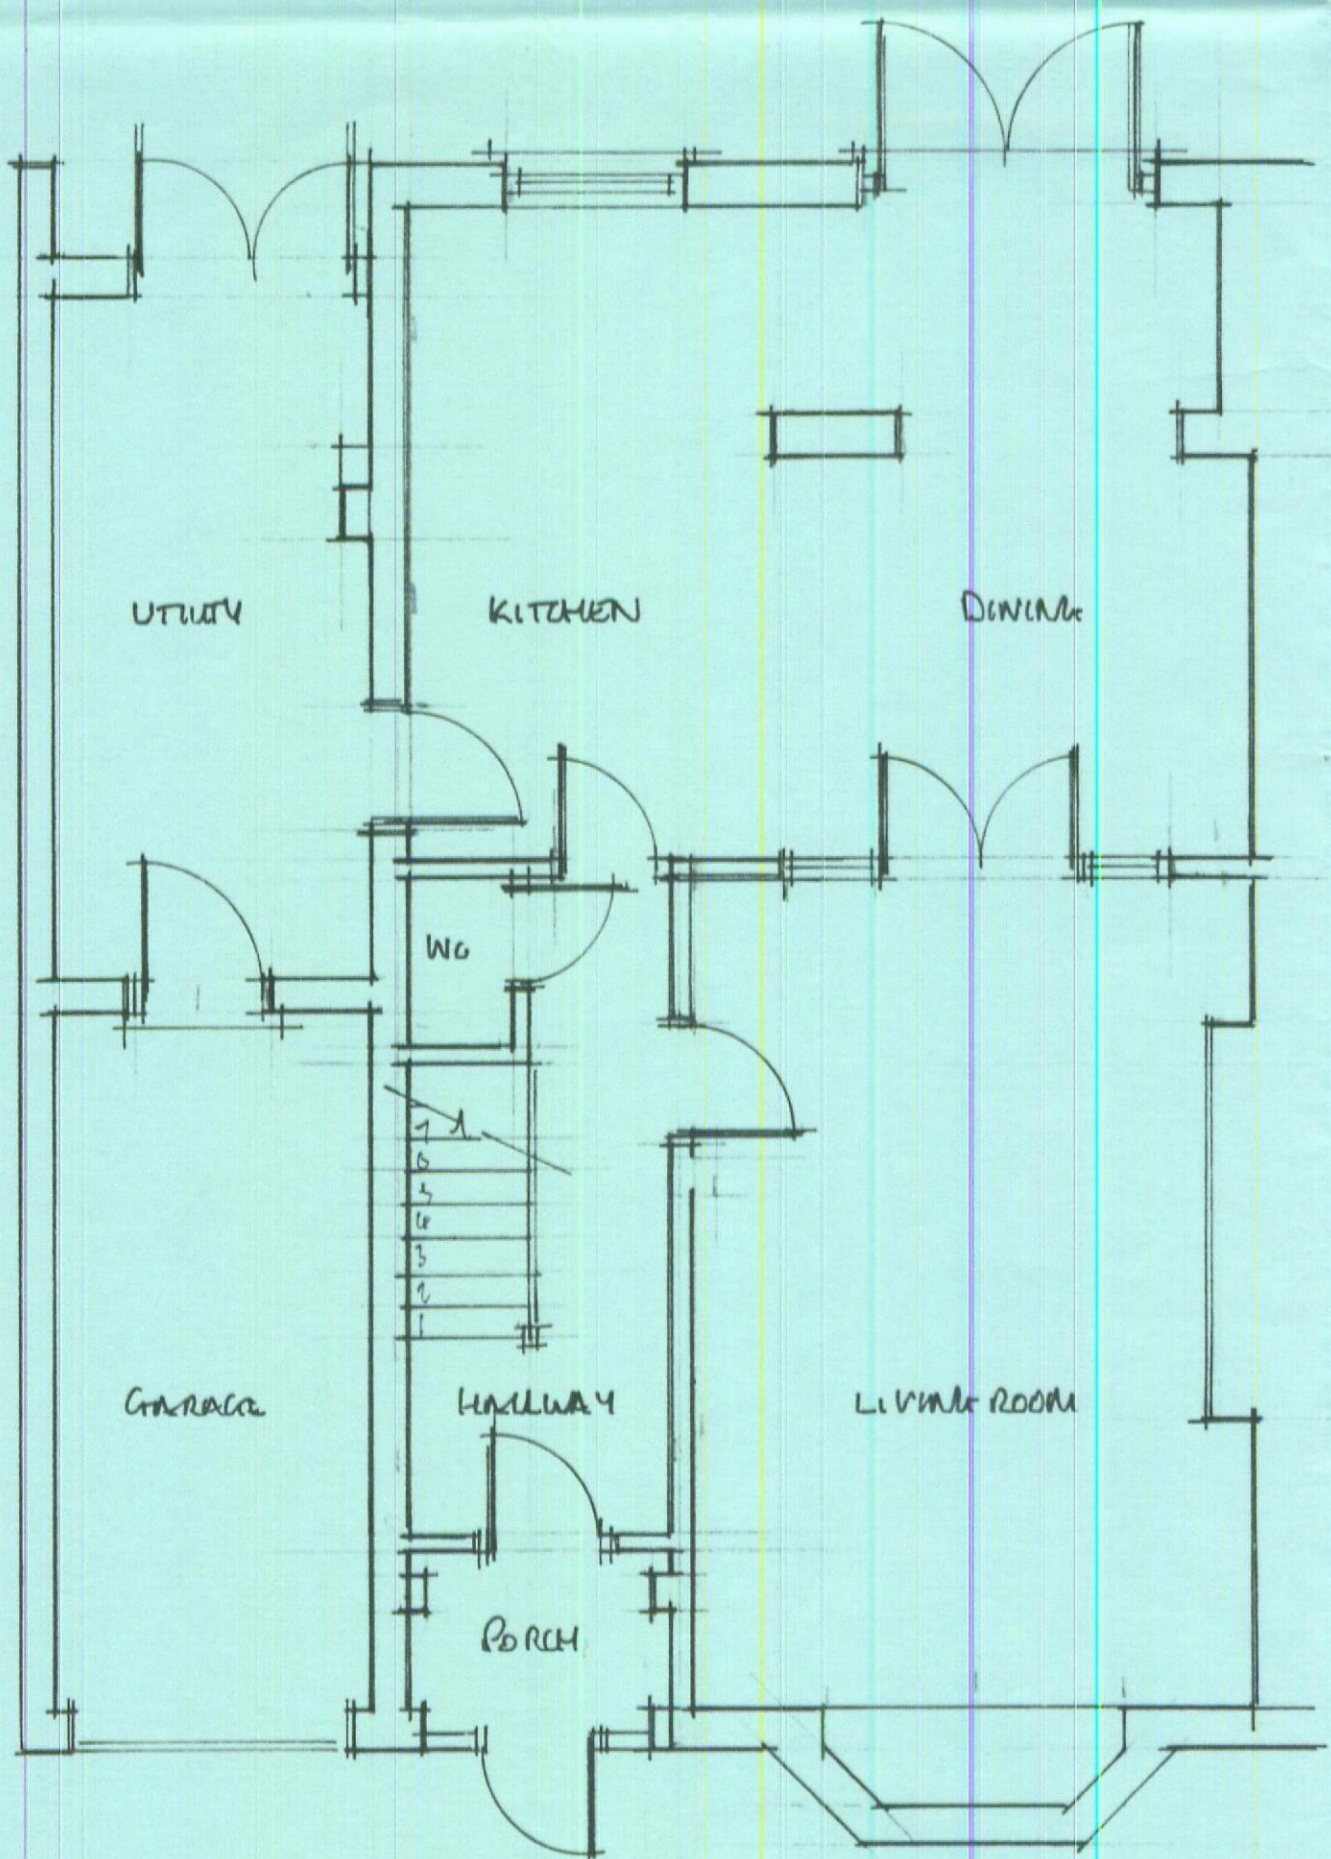

GROUND FLOOR PLAN

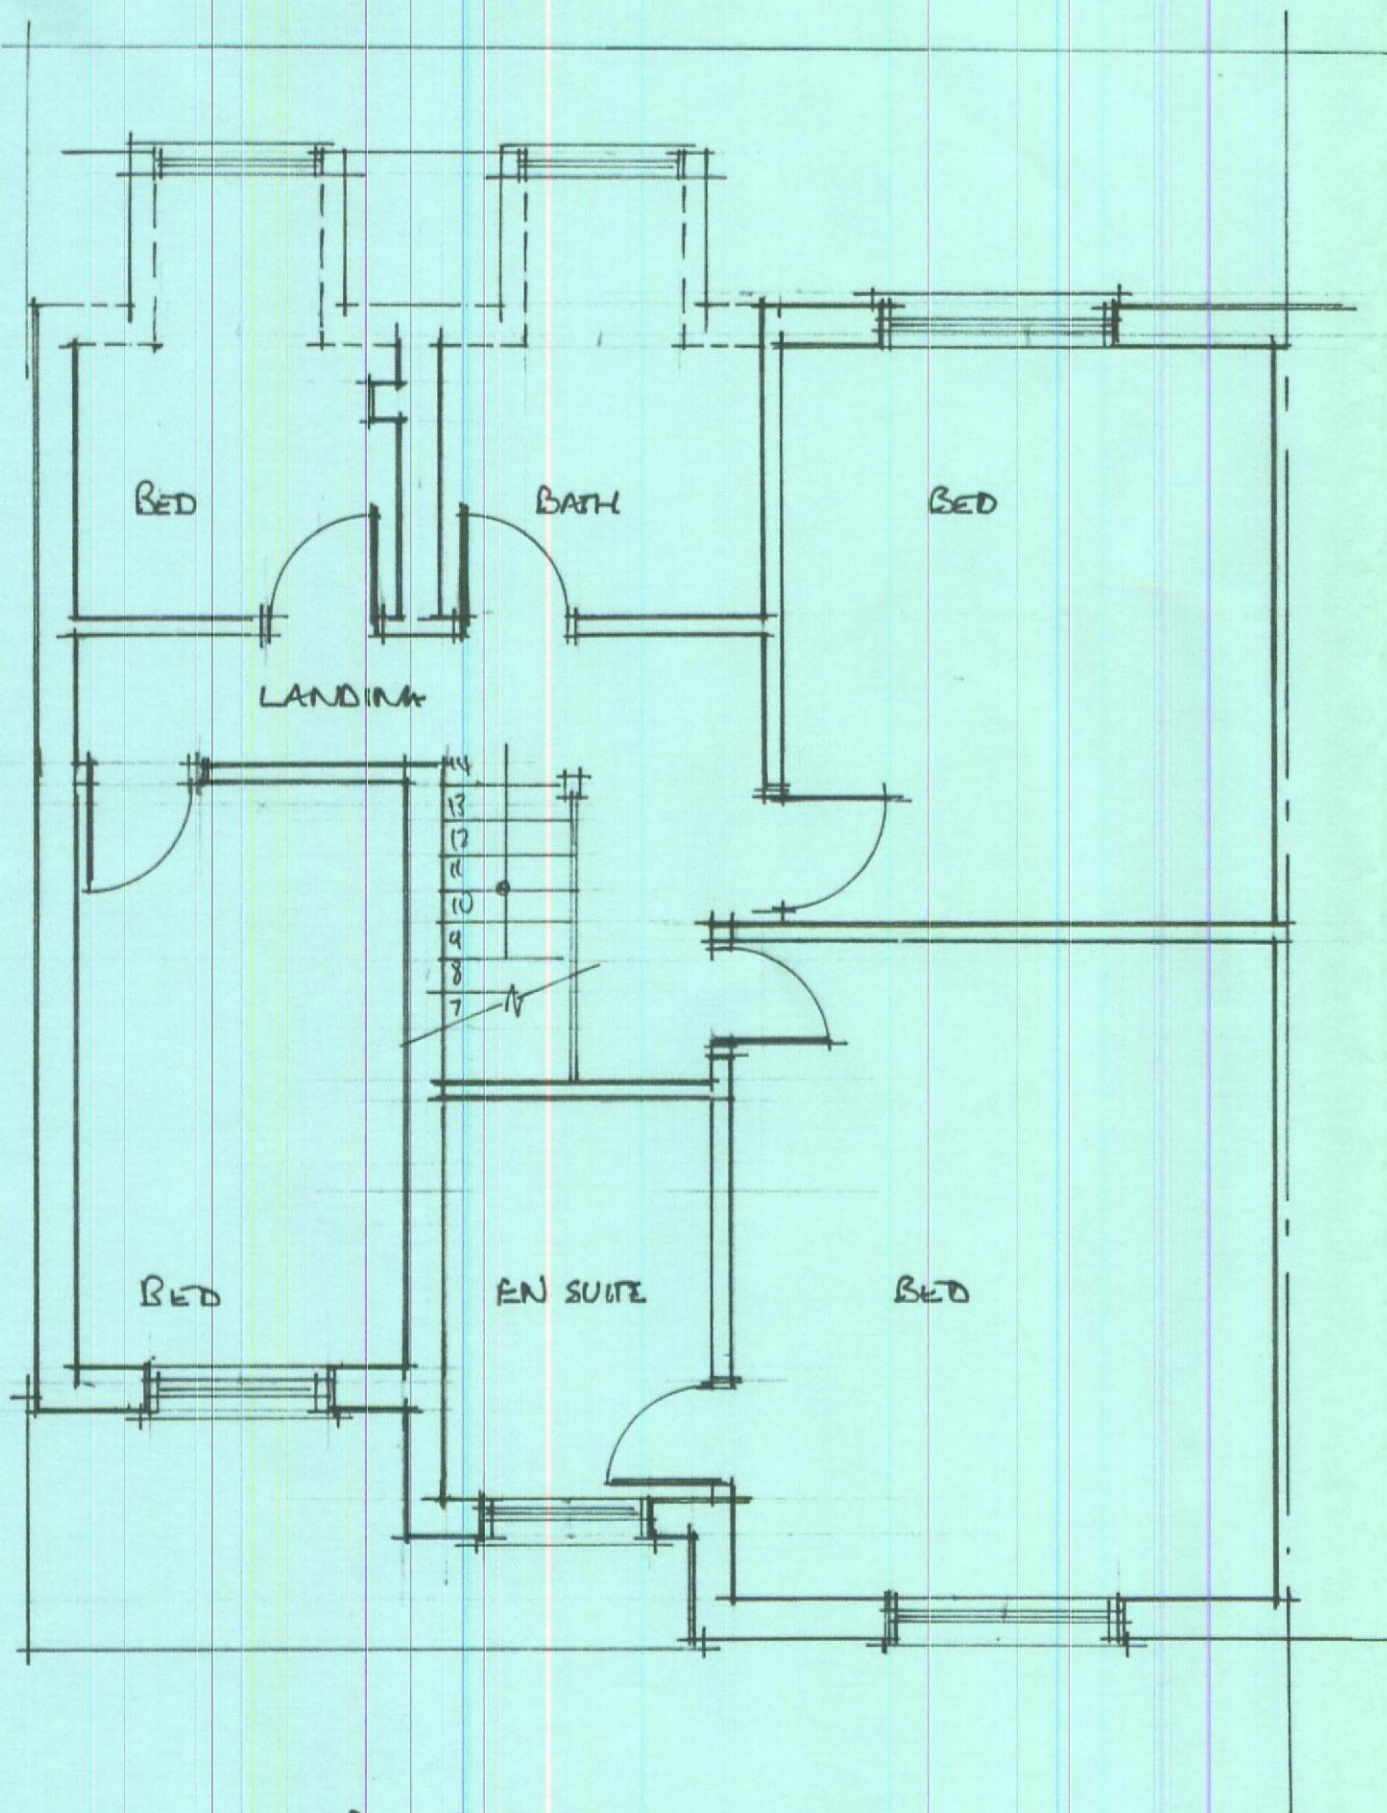

FIRST FLOOR PLAN

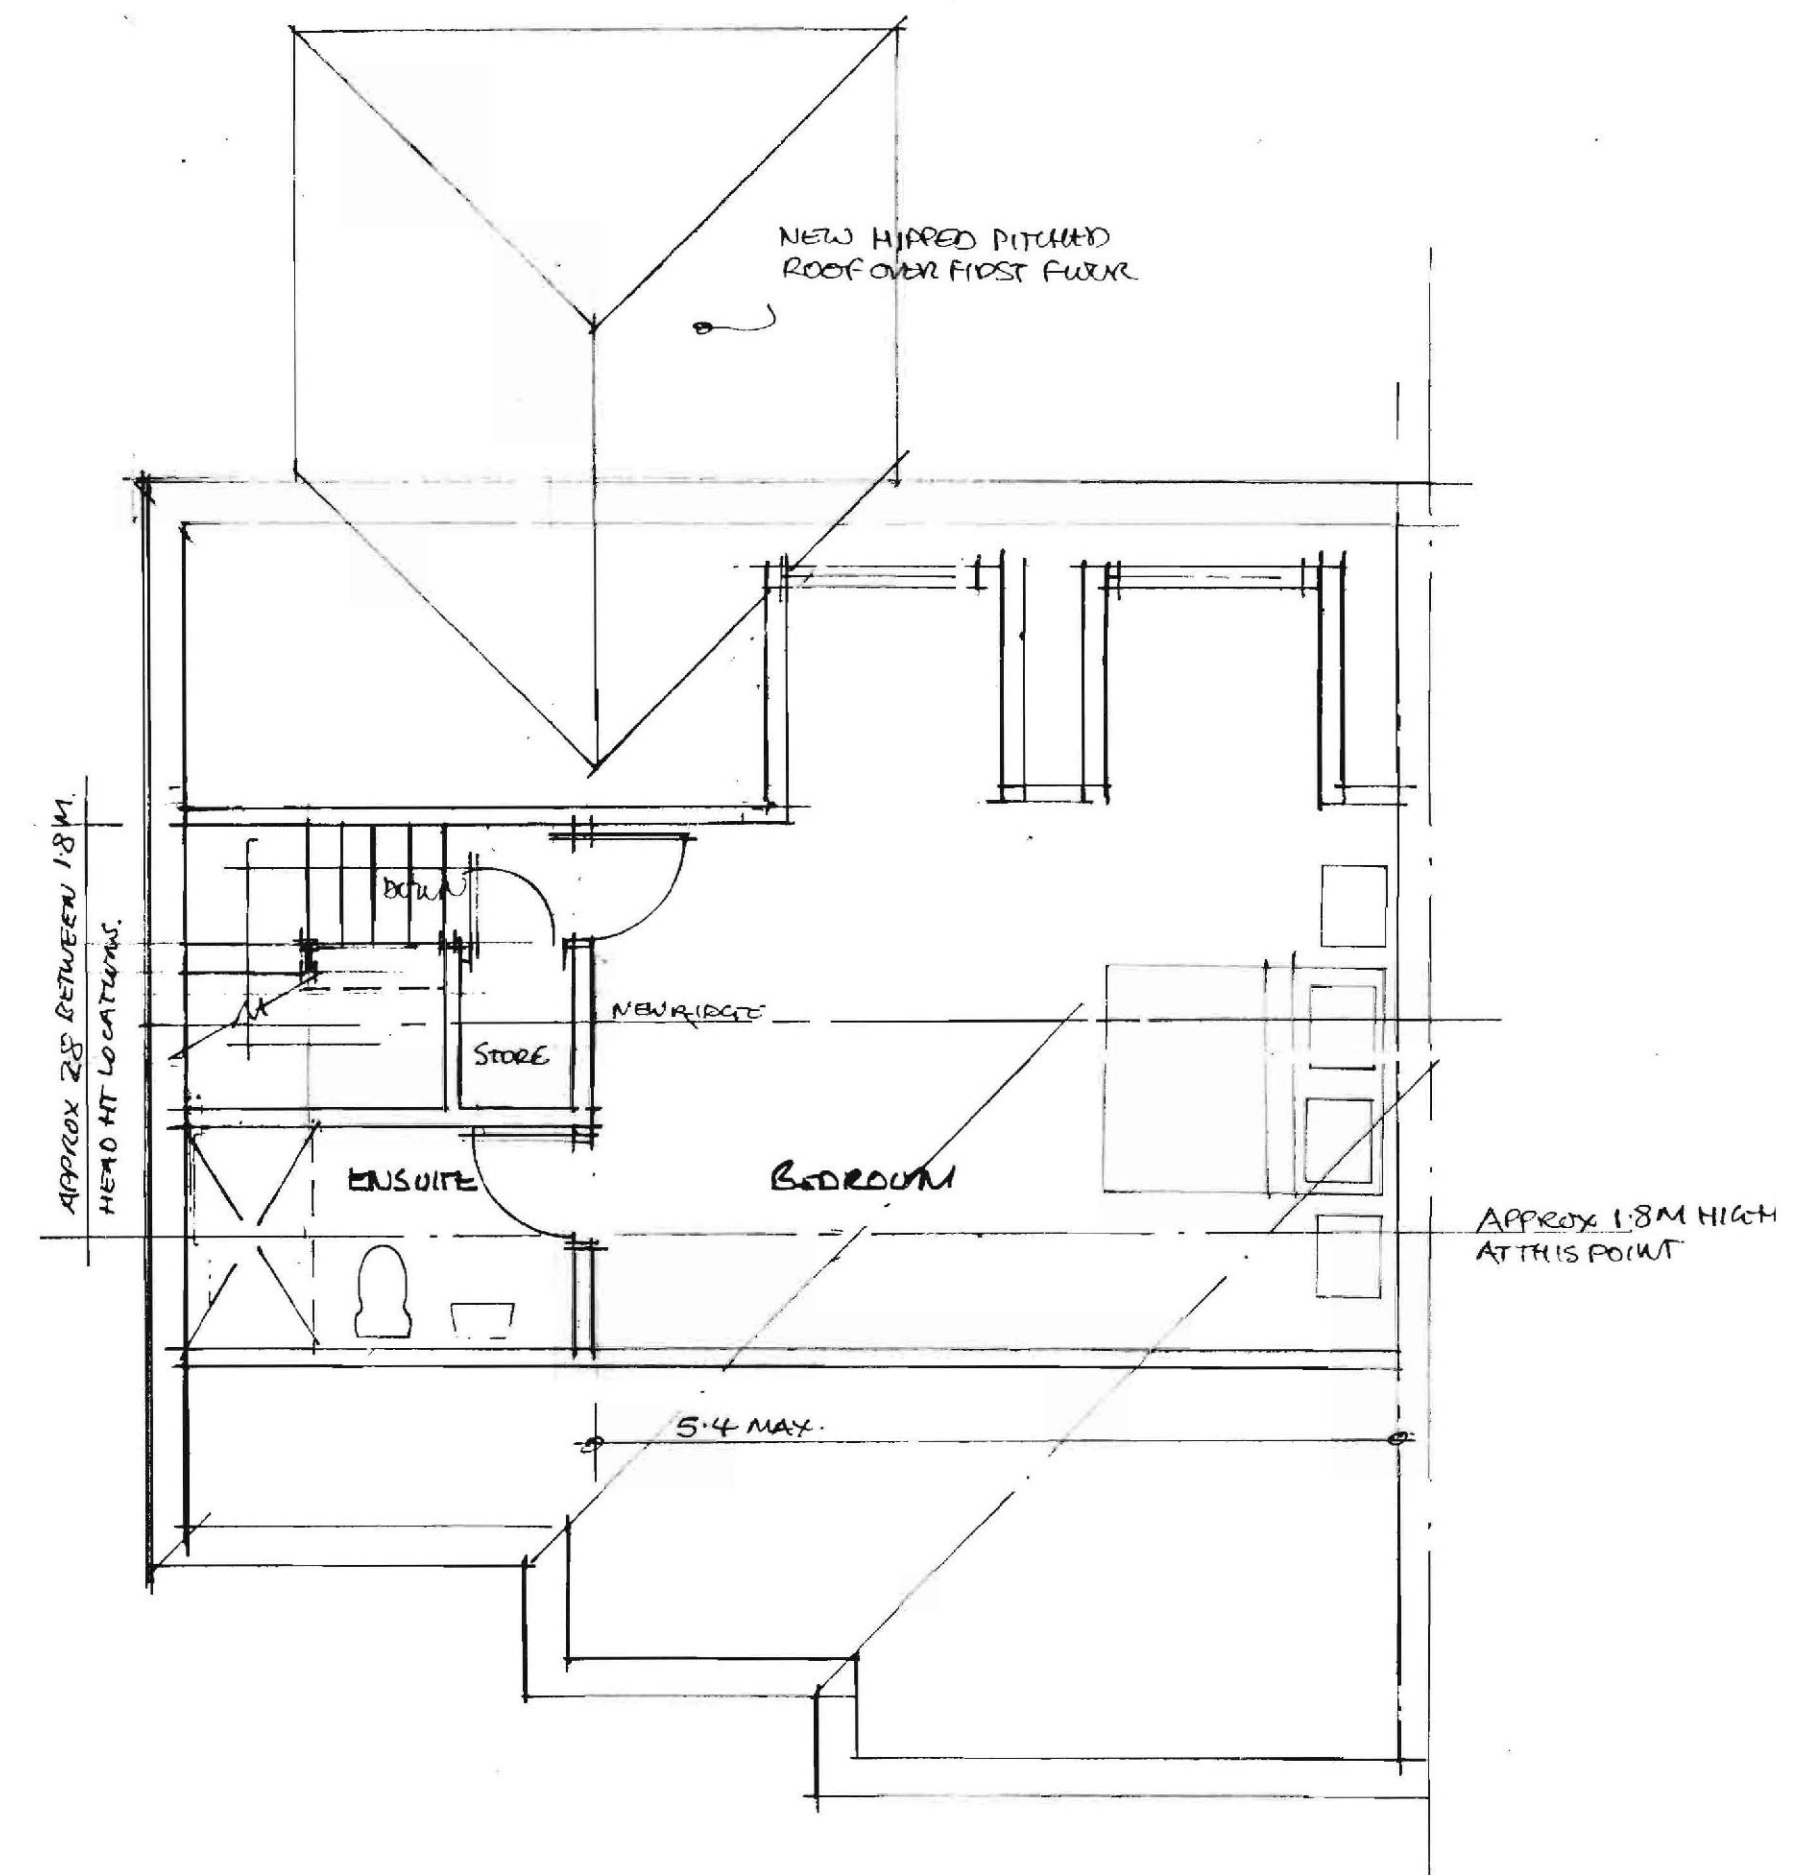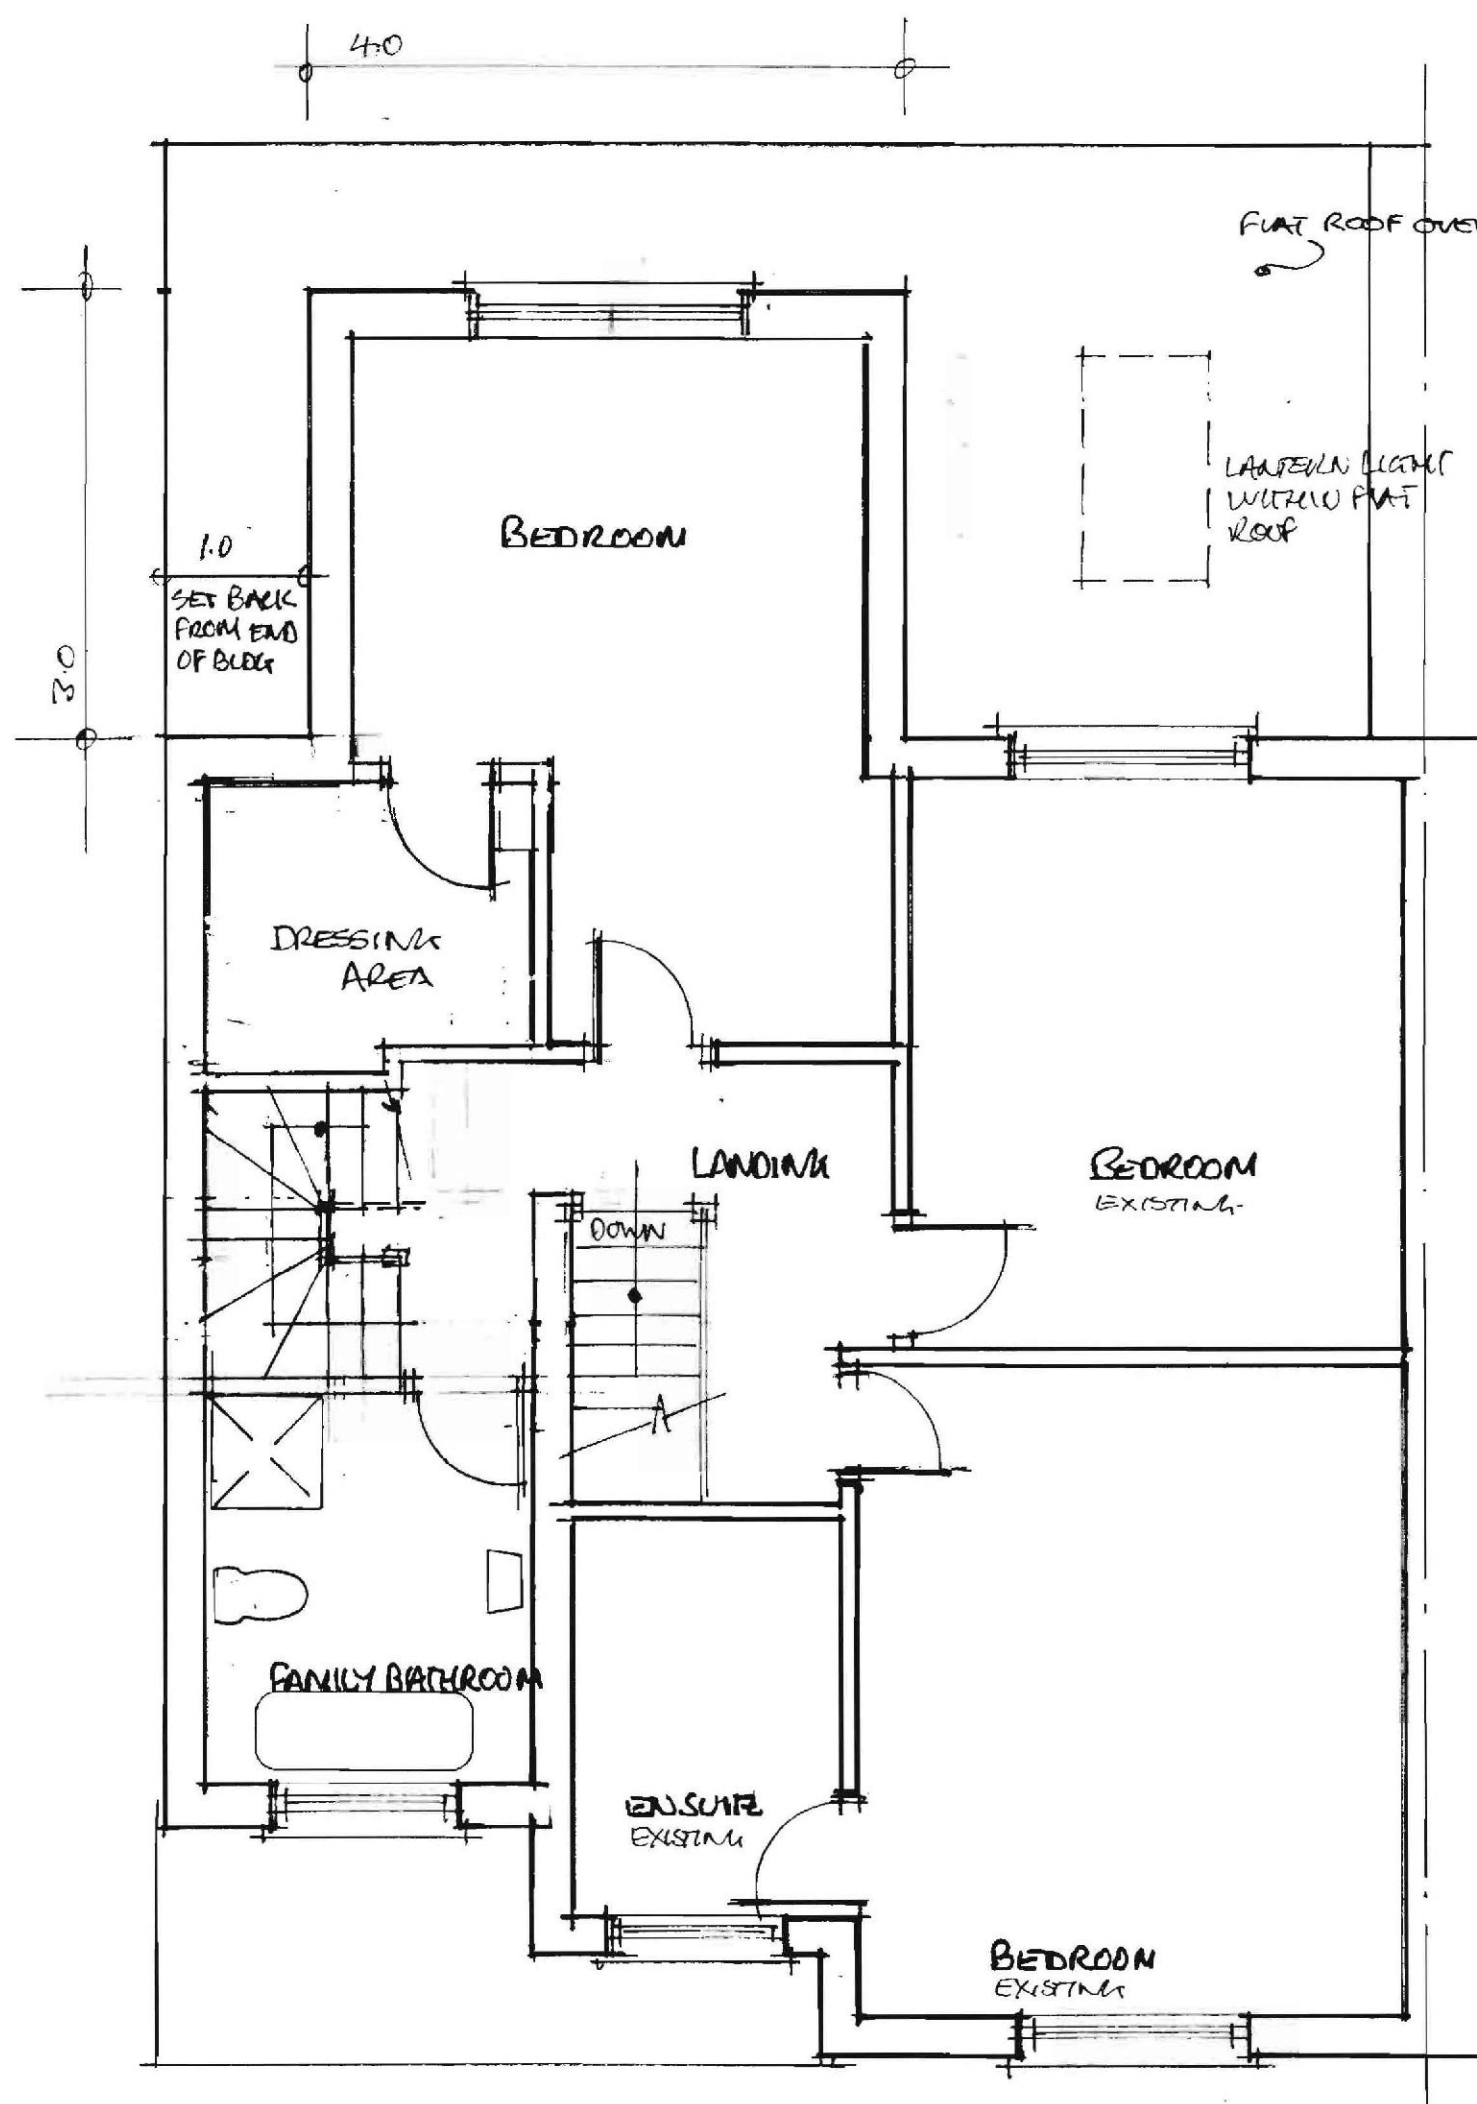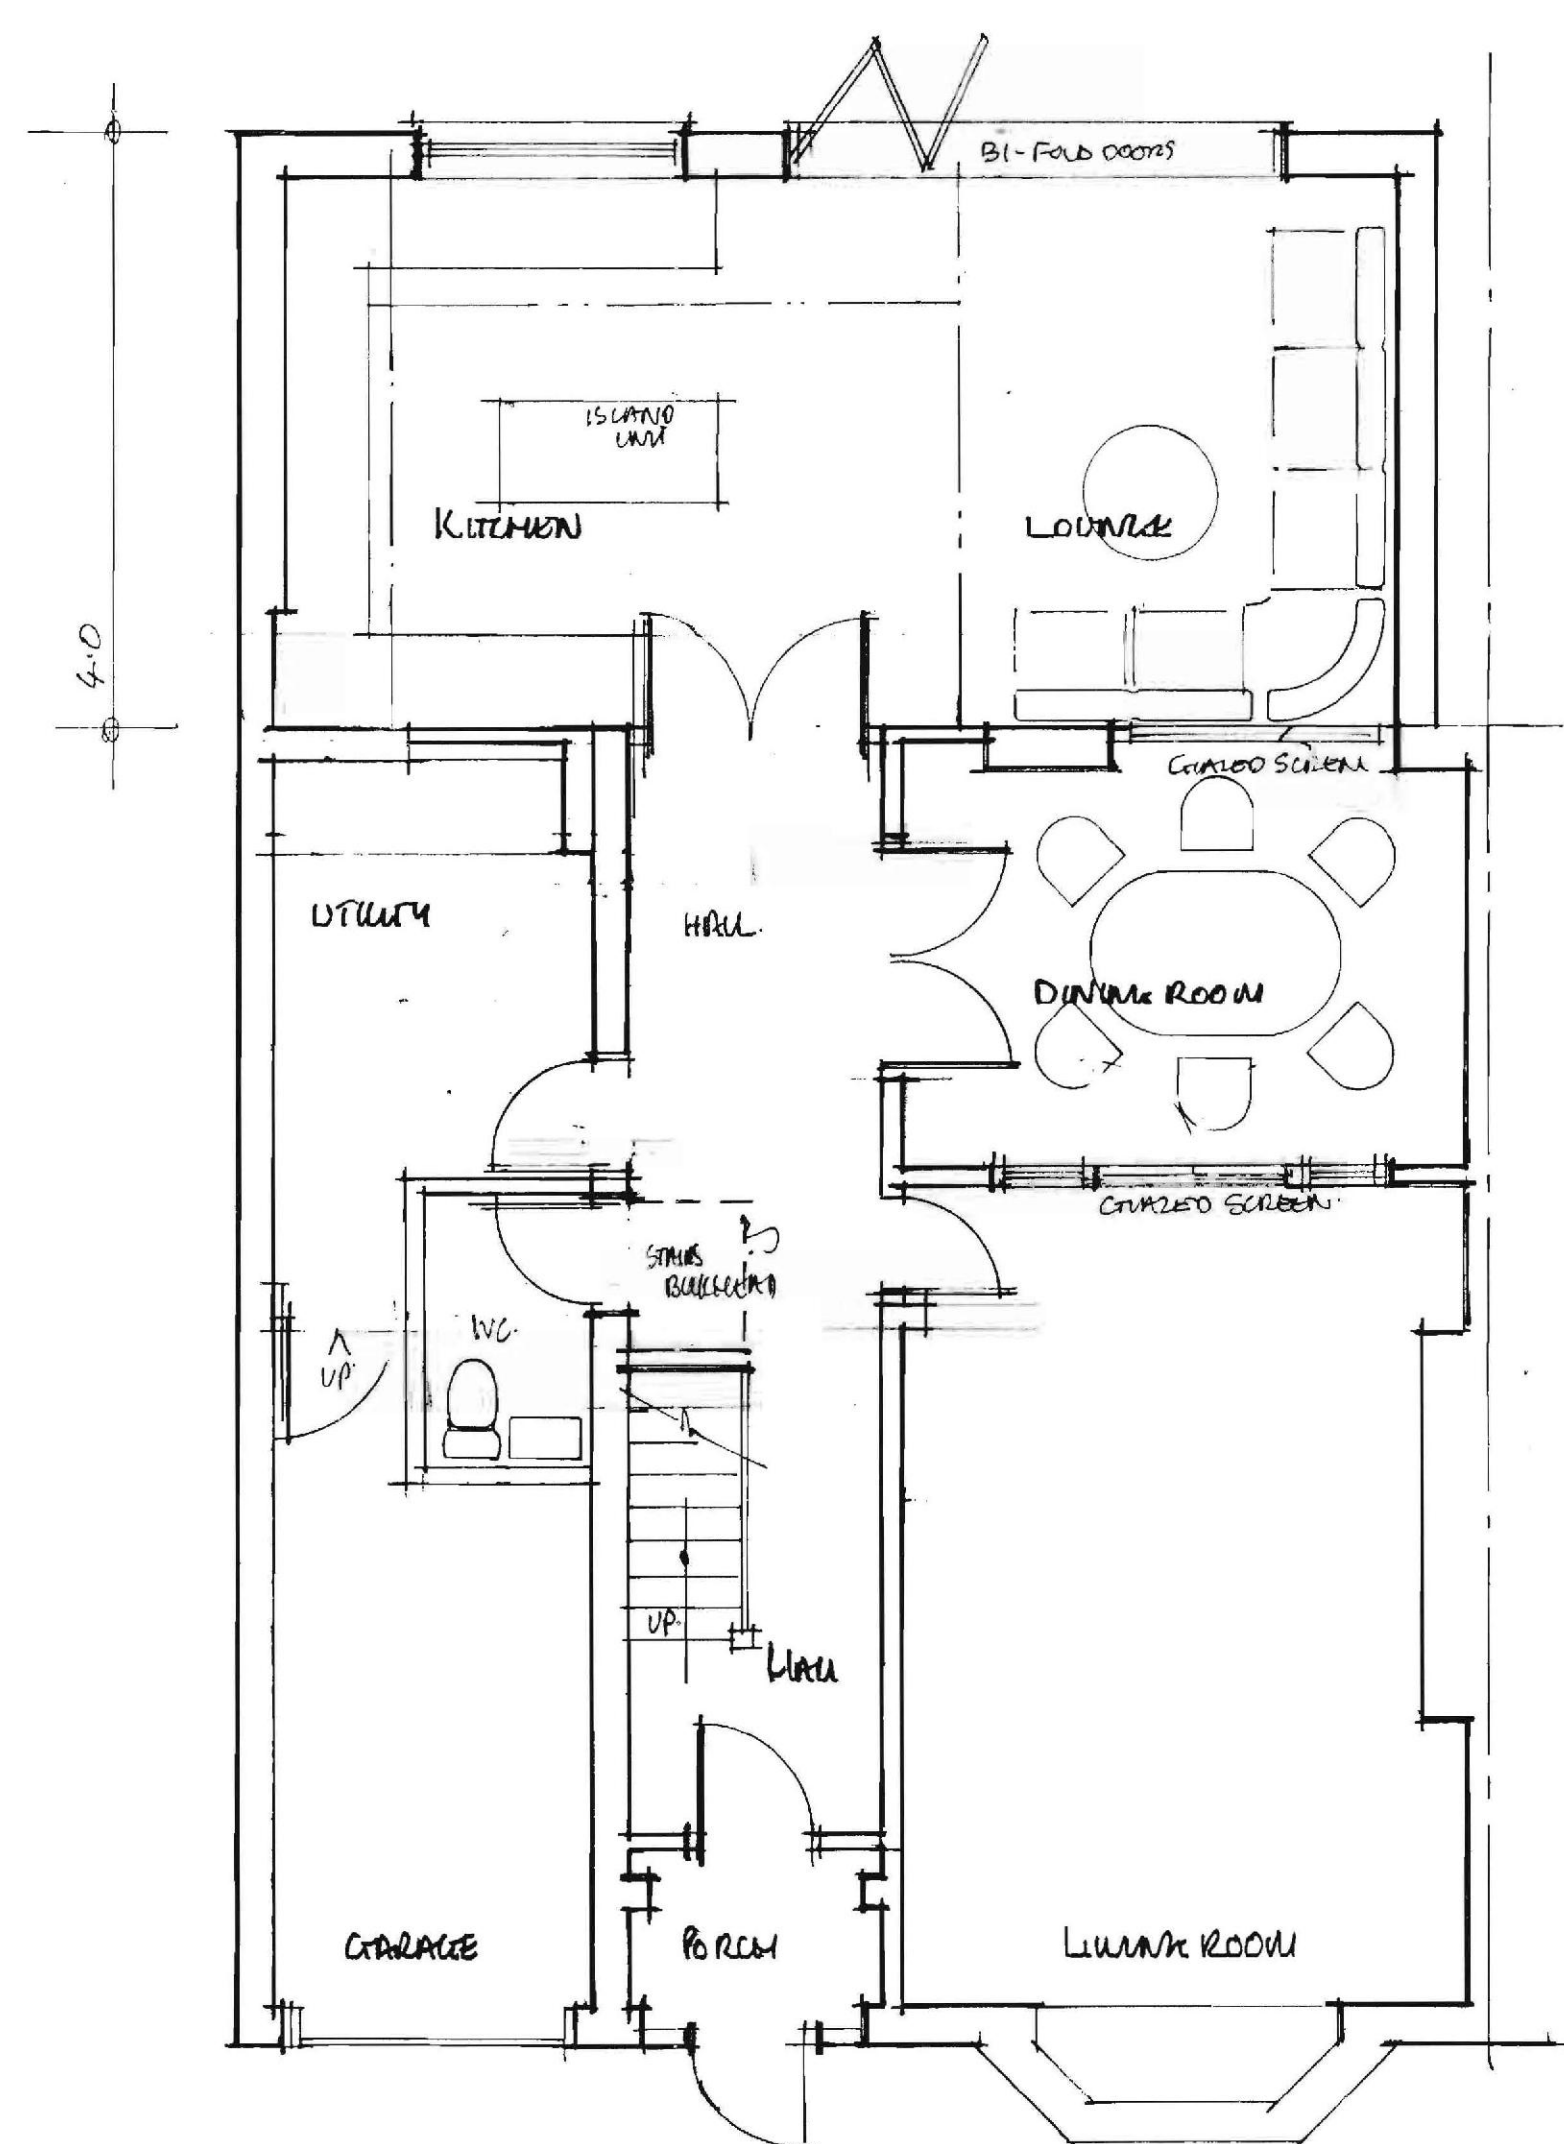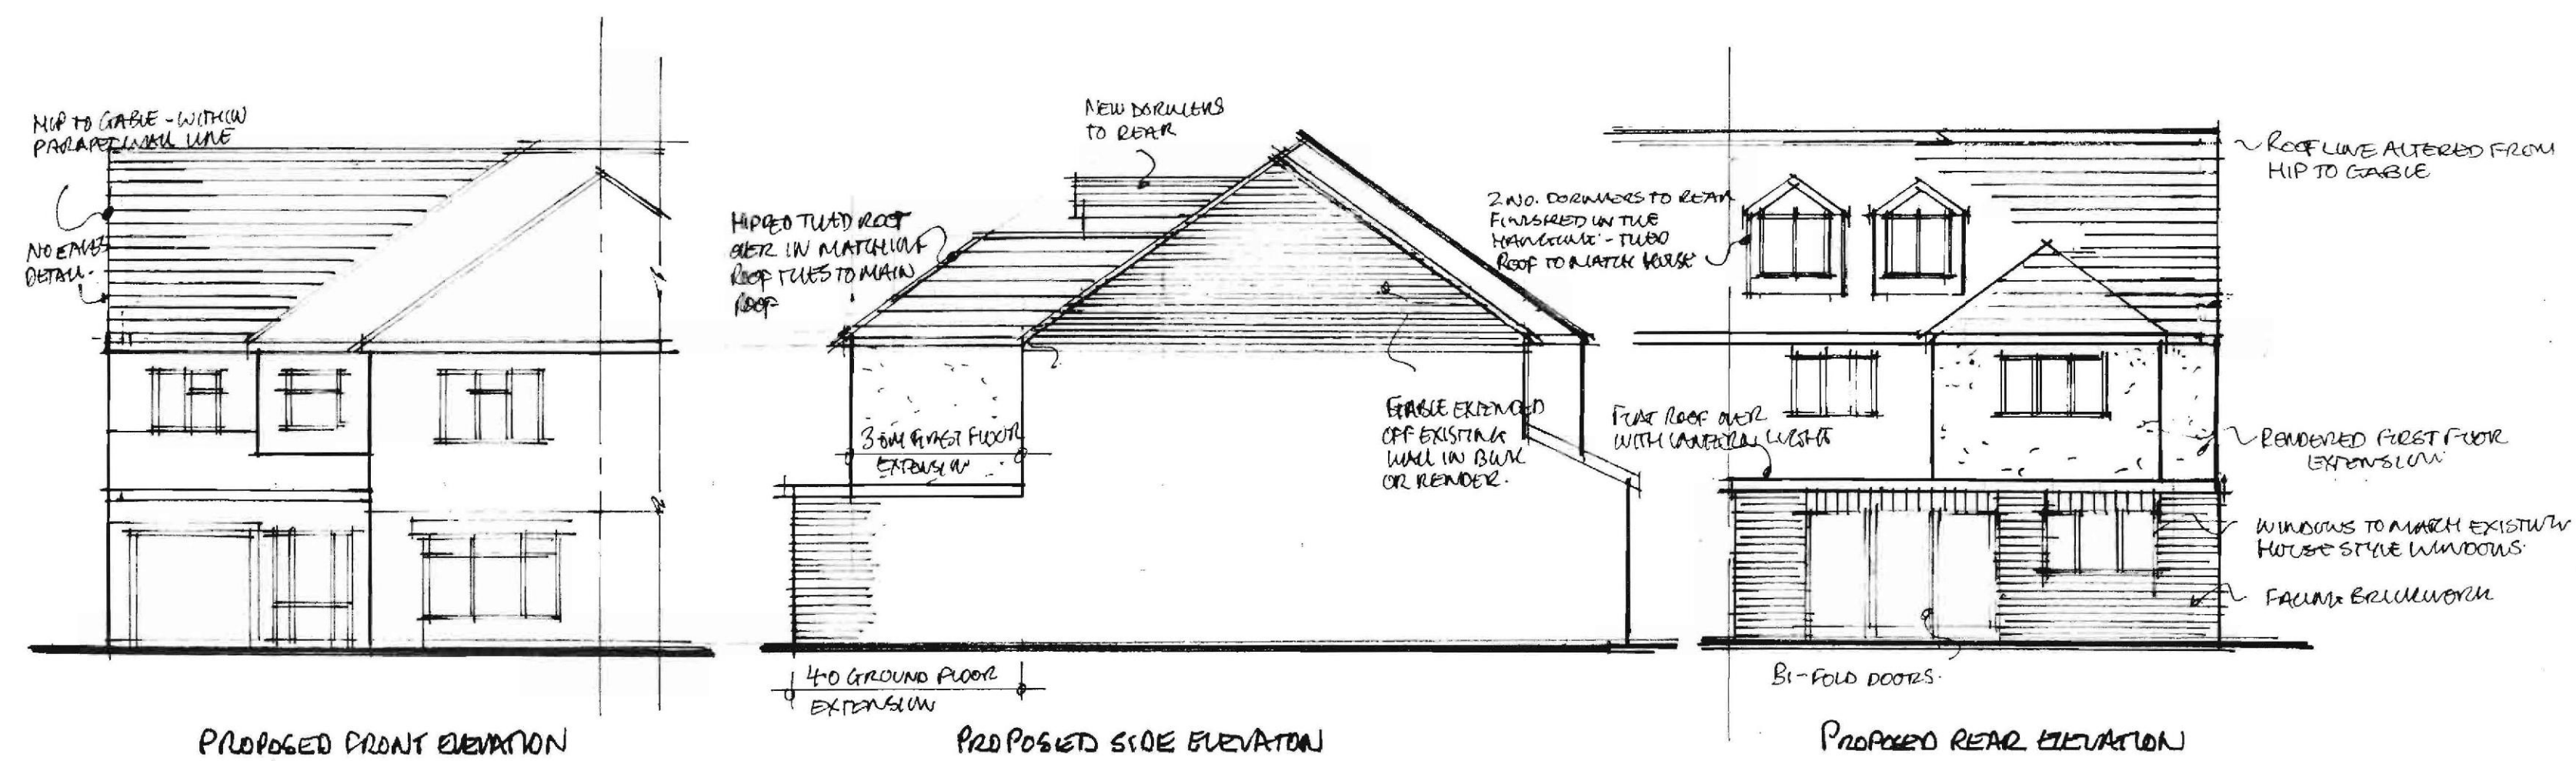

PROPOSED GROUND FLOOR

PROPOSED FIRST FLOOR

PROPOSED LOFT CONVERSION

GENERAL NOTES:

Do not scale: use given dimensions only. All setting out to be verified on site and any discrepancies notified to the Architect.


NOTES



rev.	date	by	description


DATE JUNE 2021	STATUS PLANNING	
SCALE 1:50 @ A3 1:100 @ A4	DRAWING PLANS & ELEVATIONS (approved under application P1815.15)	DWG NO. 105 REV.
DRAWN BY EA	CLIENT MR M RUFFELL	

bla architects ARCHITECTURE • INTERIOR DESIGN • PROJECT MANAGEMENT Studio 6, Rosebery House, 70 Rosebery Avenue London EC1R 4RR tel: 0207 278 1945 mail@bla-architects.com www.bla-architects.com		
PROJECT 100 INGREBOURNE GARDENS UPMINSTER RM14 1BW	JOB NO. 493	

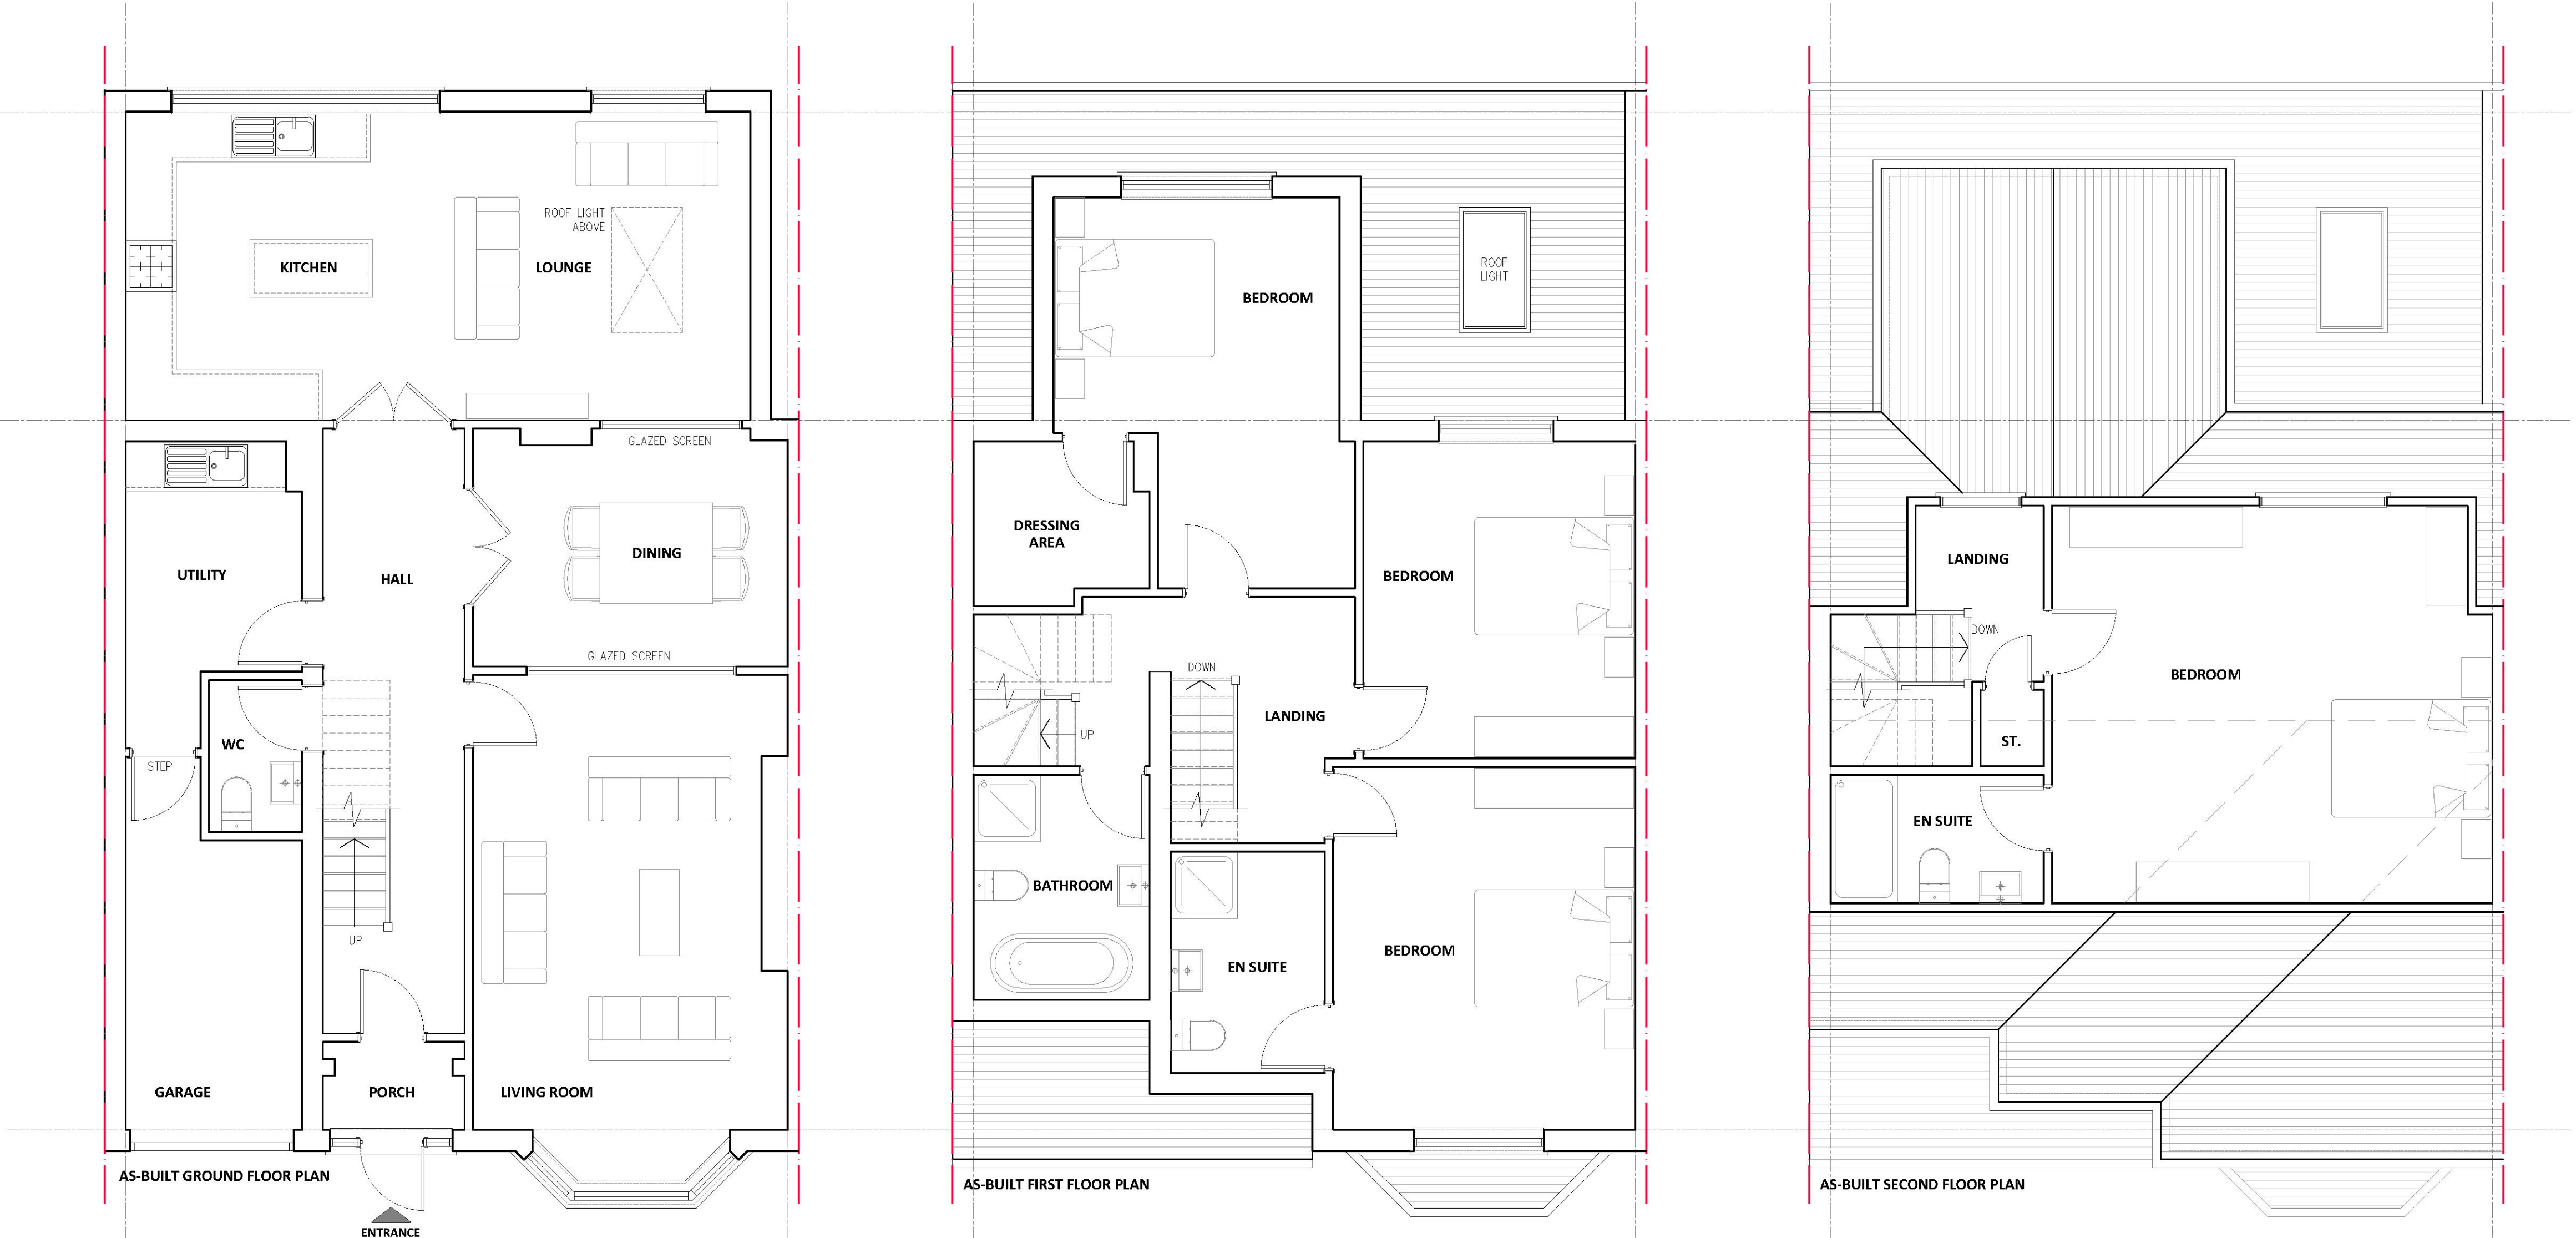

GENERAL NOTES:
Do not scale; use given dimensions only. All setting out to be verified on site and any discrepancies notified to the Architect.

NOTES

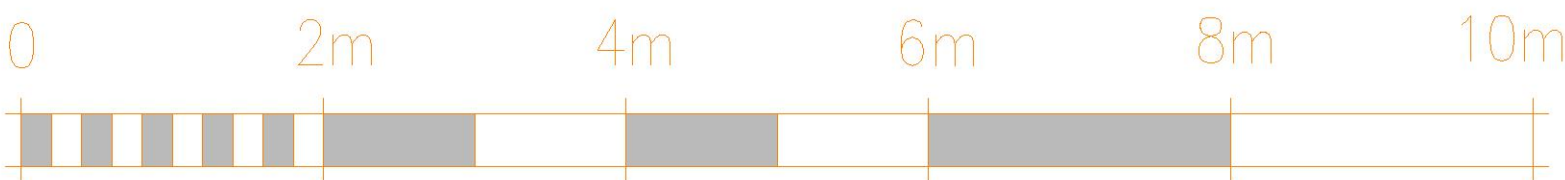

rev.	date	by	description

DATE JUNE 2021	STATUS PLANNING	
SCALE 1:50 @ A1	DRAWING FLOORPLANS AS-BUILT	DWG NO. 106 REV.
DRAWN BY JO	CLIENT MR M RUFFELL	PROJECT 100 INGEBOURNE GARDENS UPMINSTER RM14 1BW
		JOB NO. 493

bla architects

ARCHITECTURE • INTERIOR DESIGN • PROJECT MANAGEMENT

Studio 6, Rosebery House, 70 Rosebery Avenue London EC1R 4RR
tel: 0207 278 1945 mail@bla-architects.com www.bla-architects.com