

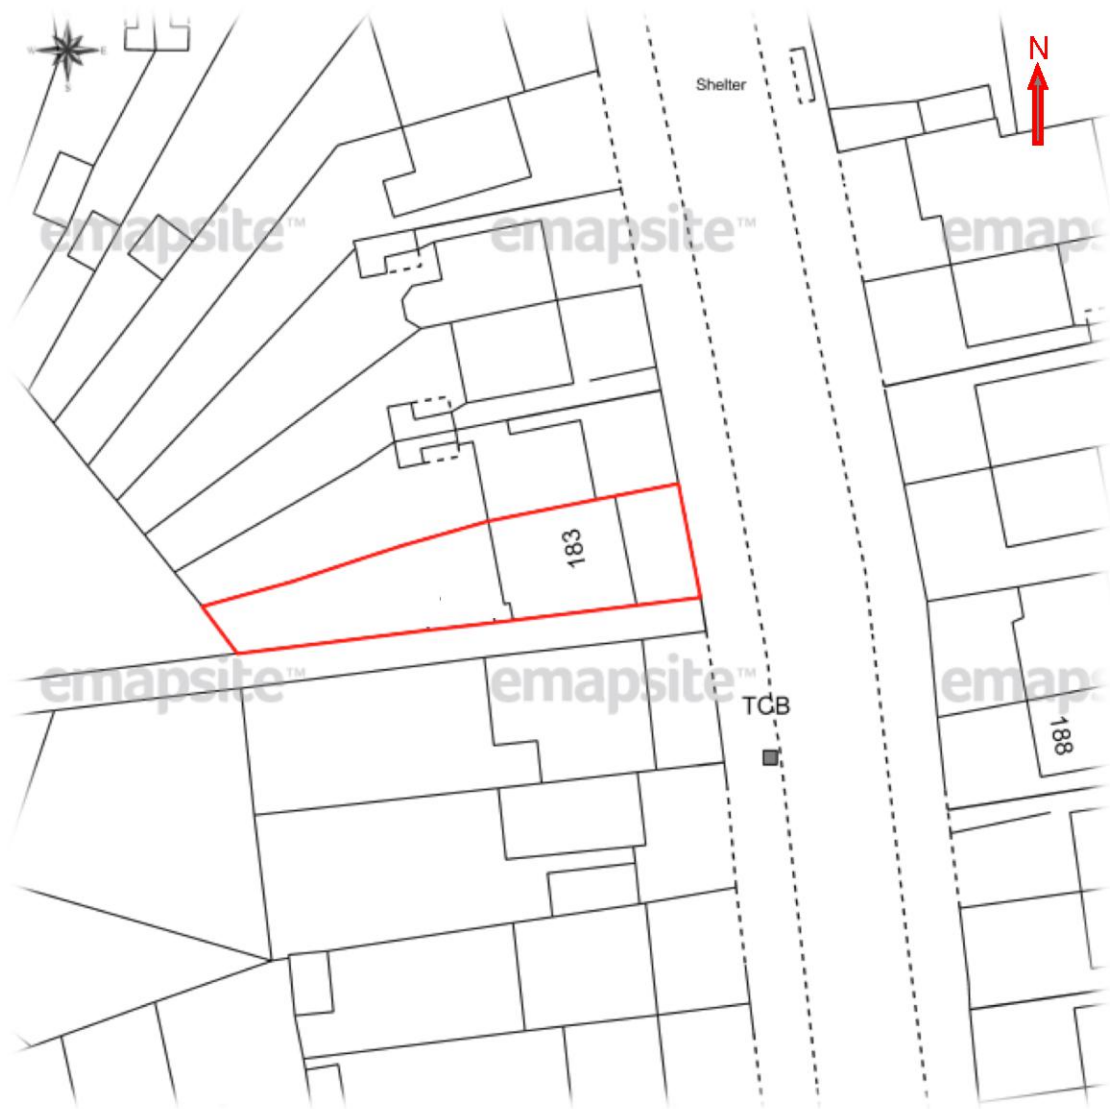



BLOCK PLAN

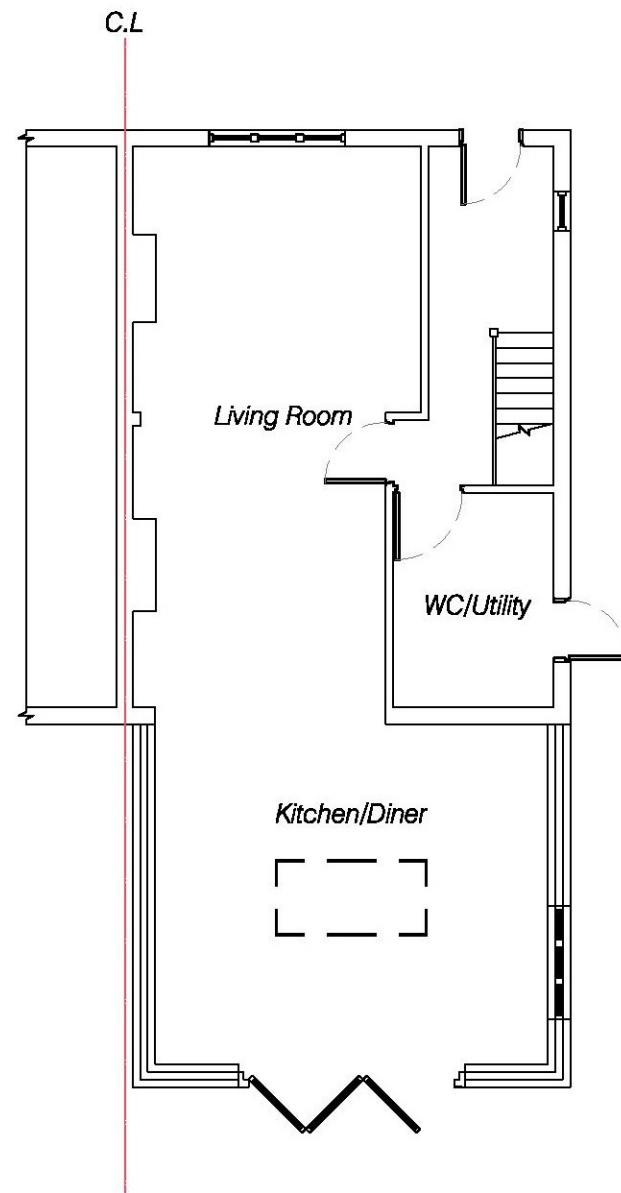

SCALE 1:500

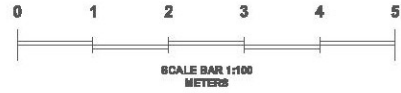

APPROVED FLOORPLAN

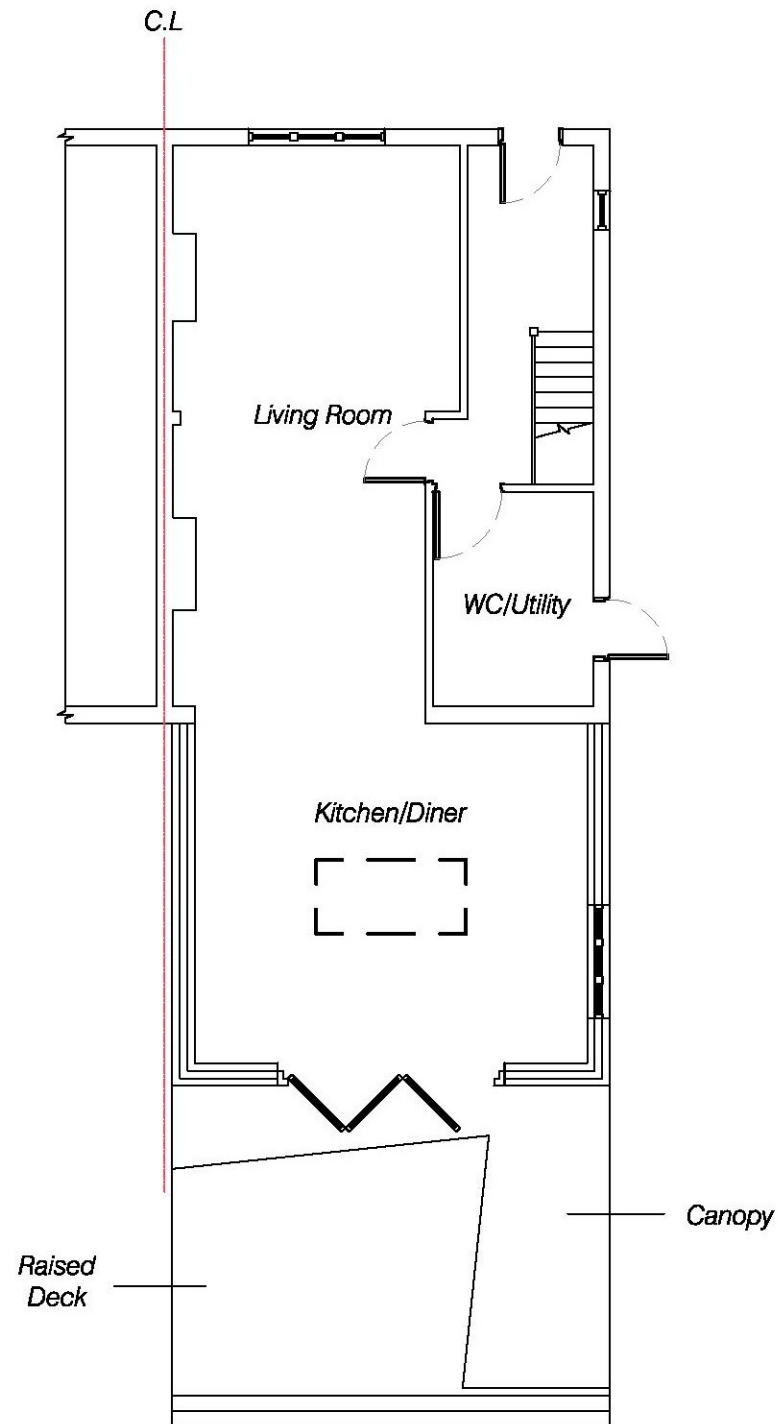

AS BUILT FLOORPLAN

Notes:

- Walls - Rendered blockwork walls
- Flat Roof - To be finished in fibre glass
- Windows - To be white UPVC to match existing
- Doors - To be white UPVC to match existing
- Lantern - Toughened seamless glass

- ALL DIMENSIONS ARE IN MILLIMETERS
- ALL DIMENSIONS ARE TO BE RECHECKED ON SITE
- ALL MATERIALS AND WORKMANSHIP TO COMPLY WITH CURRENT BRITISH STANDARDS AND CODES PRACTICE

Client:

Mr Imran Anwar

Site address:

183 Clockhouse Lane, Romford, Essex RM5 2TL

Project:

Single Storey Rear Extension

Drawn by:

RS

Date:


21st January 2023

Scale:

1:100 @ A3

Drawing number:

183CR-SSRE-001

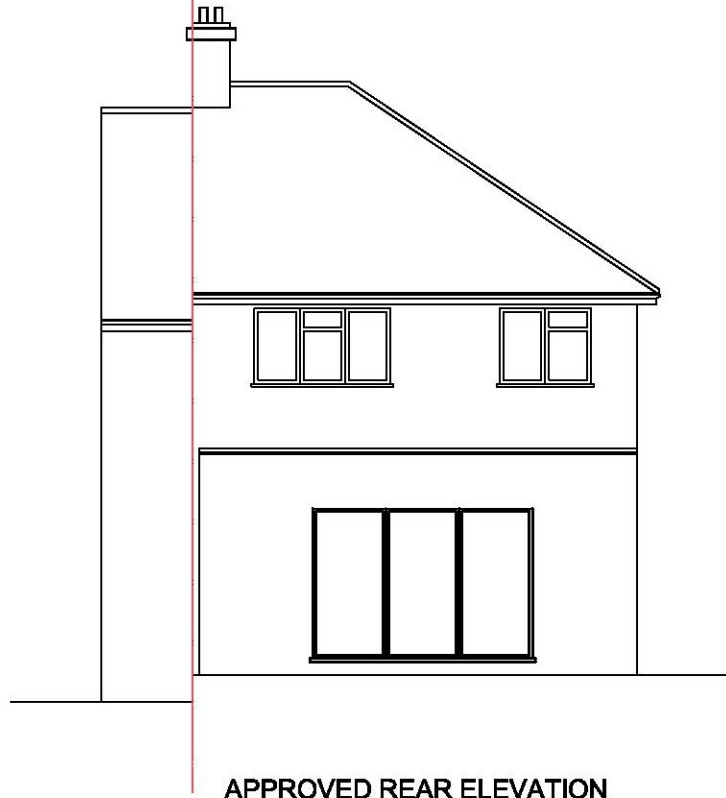


APPROVED REAR ELEVATION




APPROVED SIDE ELEVATION

- Notes:
- Walls - Rendered blockwork walls
 - Flat Roof - To be finished in fibre glass
 - Windows - To be white UPVC to match existing
 - Doors - To be white UPVC to match existing
 - Lantern - Toughened seamless glass

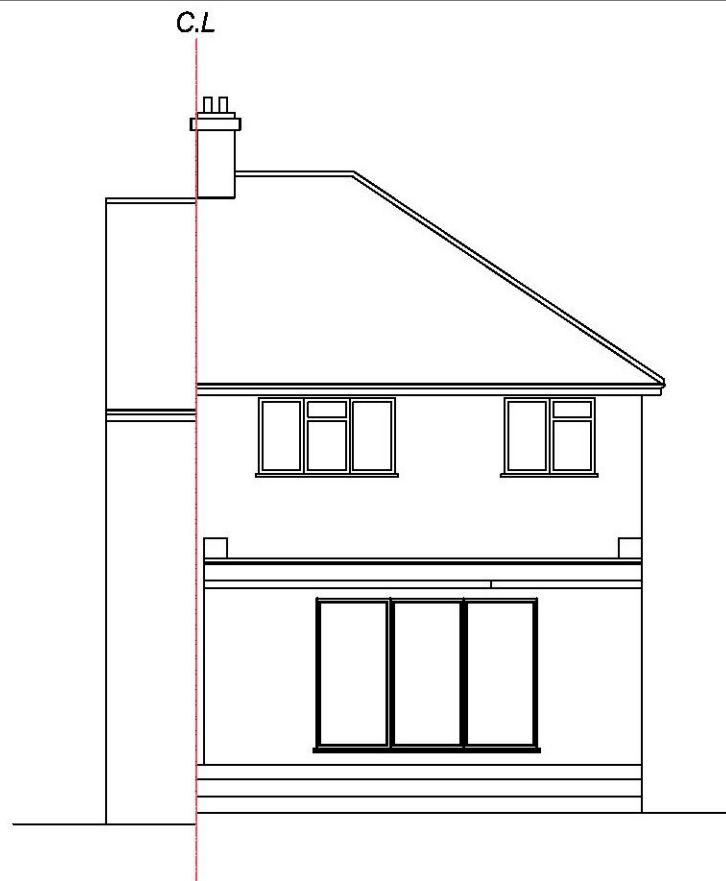

AS BUILT REAR ELEVATION

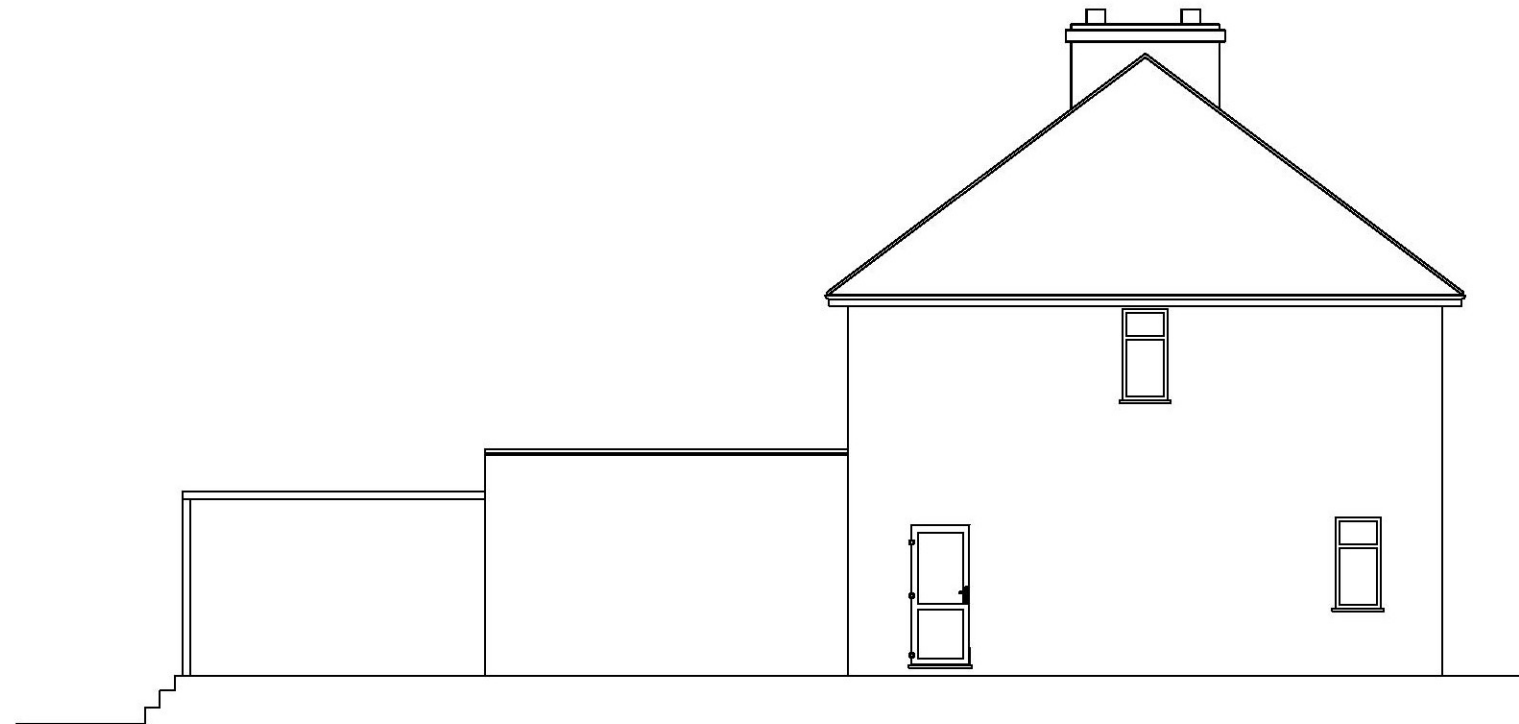

AS BUILT SIDE ELEVATION

- ALL DIMENSIONS ARE IN MILLIMETERS
- ALL DIMENSIONS ARE TO BE RECHECKED ON SITE
- ALL MATERIALS AND WORKMANSHIP TO COMPLY WITH CURRENT BRITISH STANDARDS AND CODES PRACTICE

Client:
Mr Imran Anwar
Site address:
183 Clockhouse Lane, Romford, Essex RM5 2TL
Project:
Single Storey Rear Extension
Drawn by:
RS
Date:
21st January 2023
Scale:
1:100 @ A3
Drawing number:
183CR-SSRE-002