


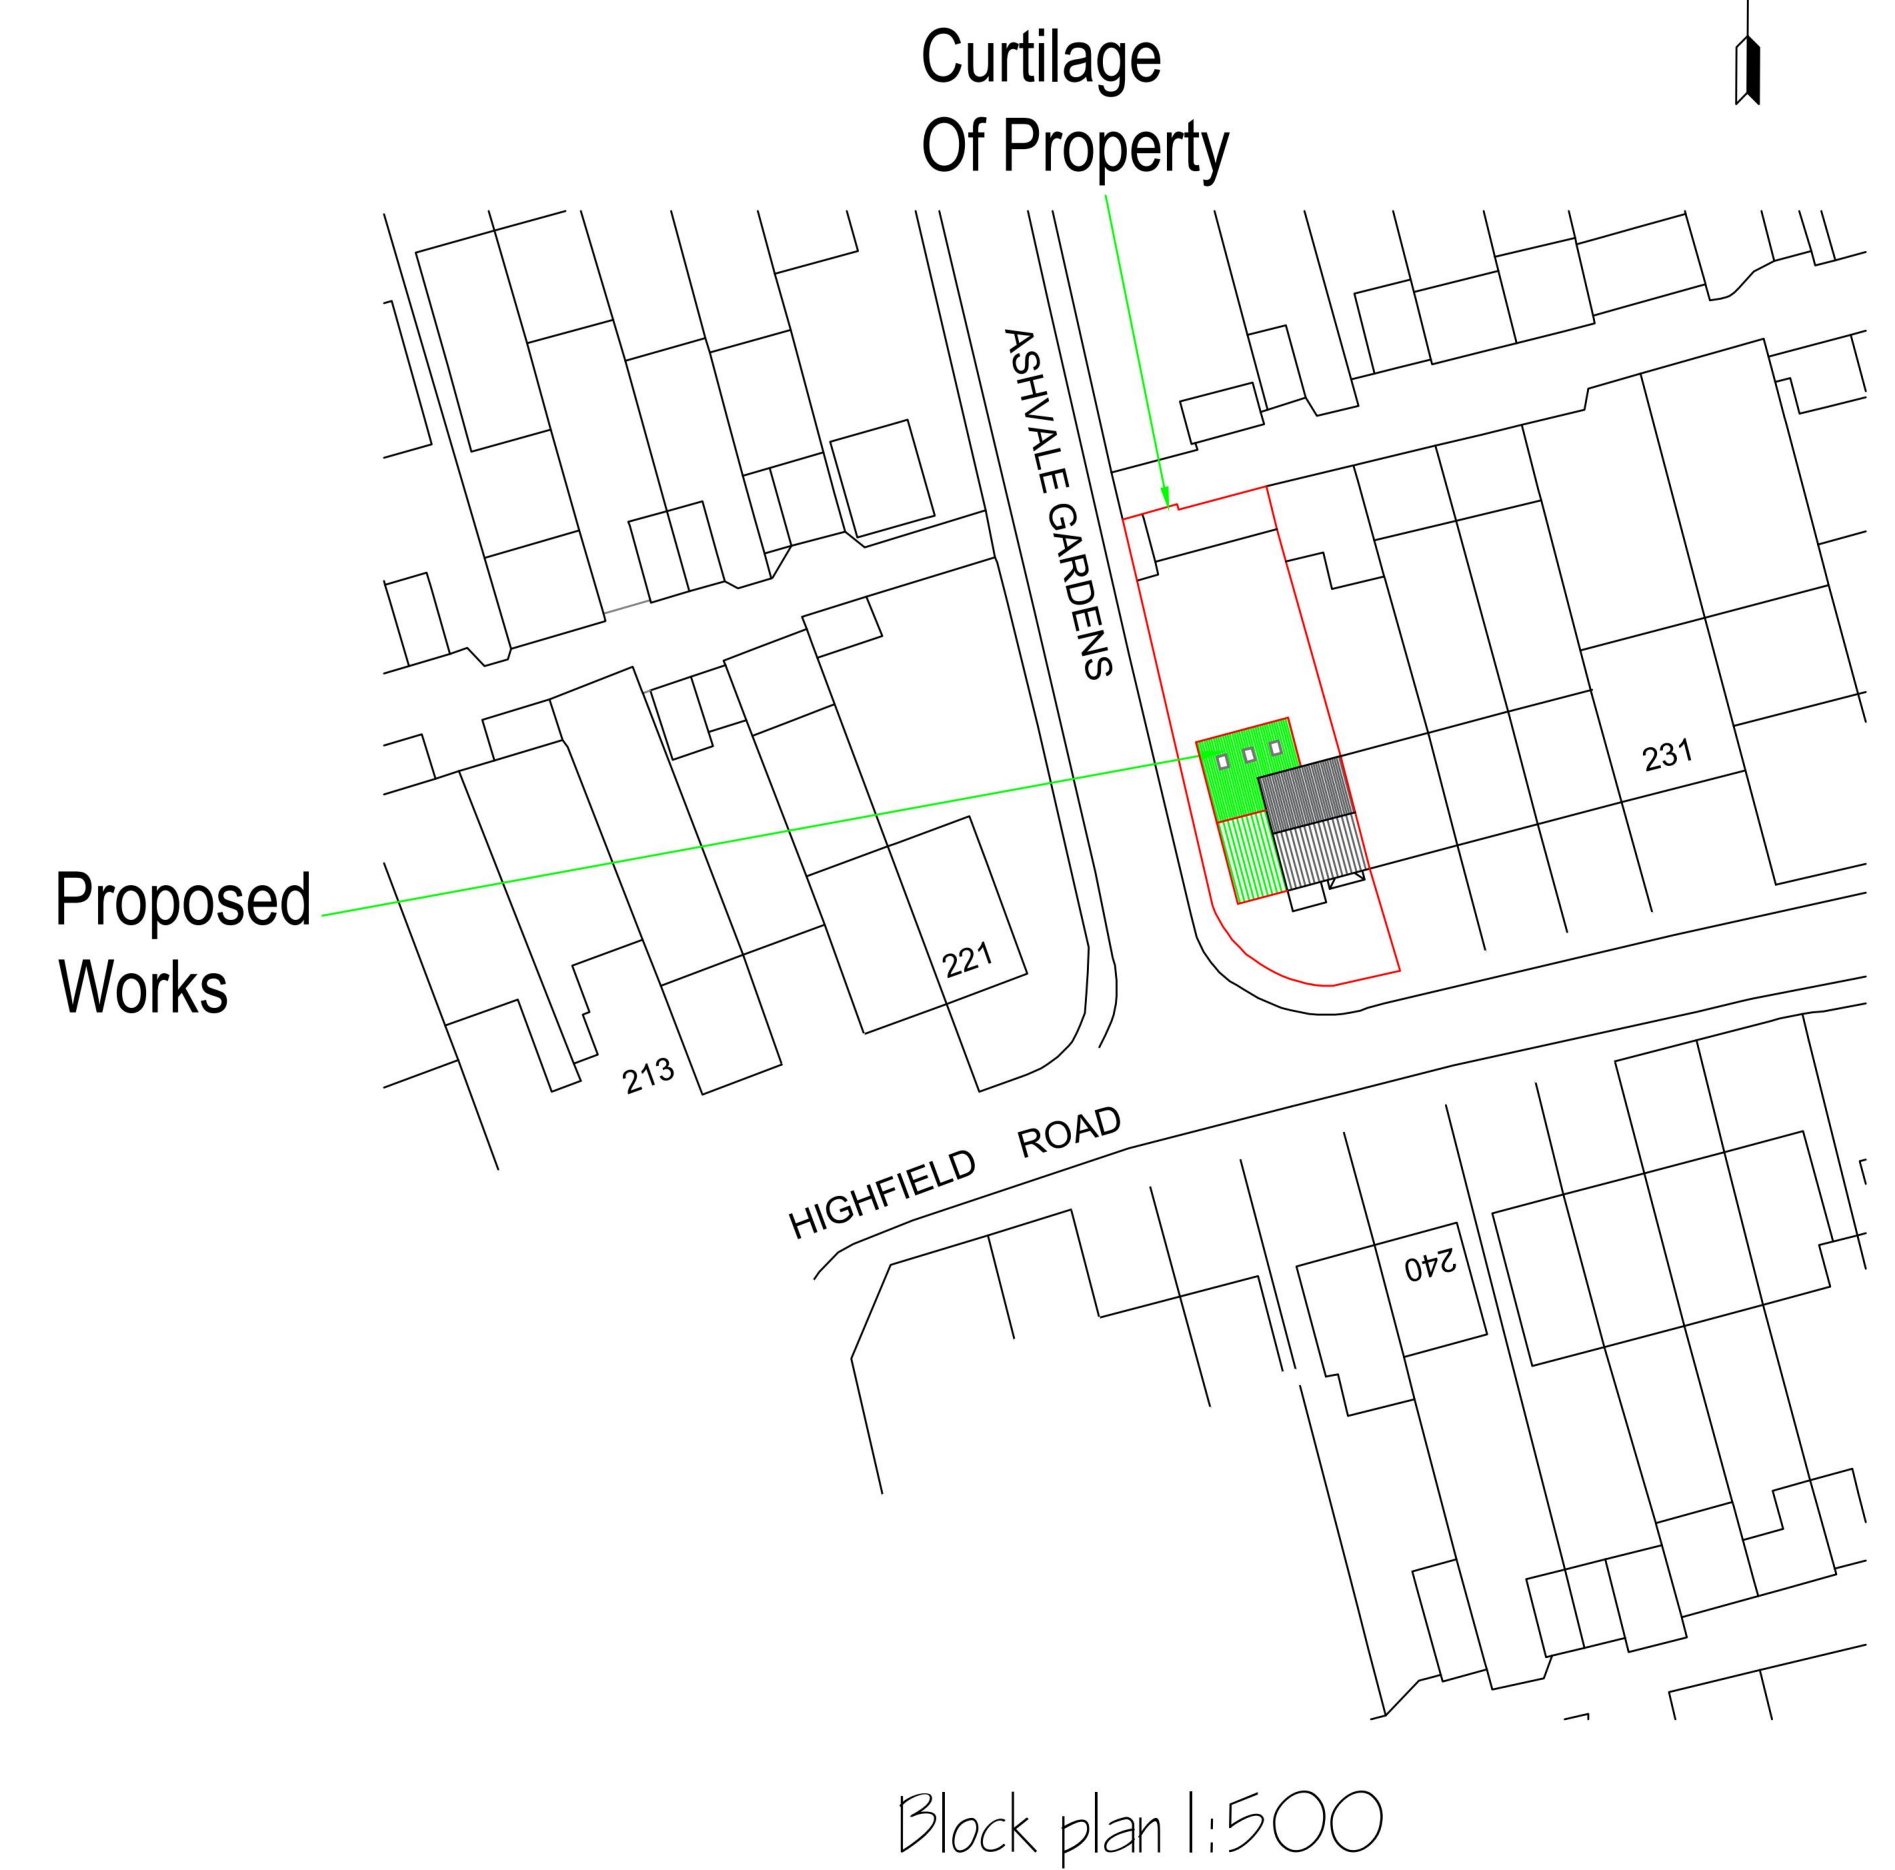
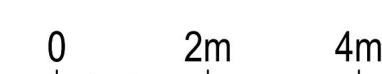
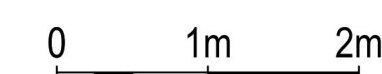
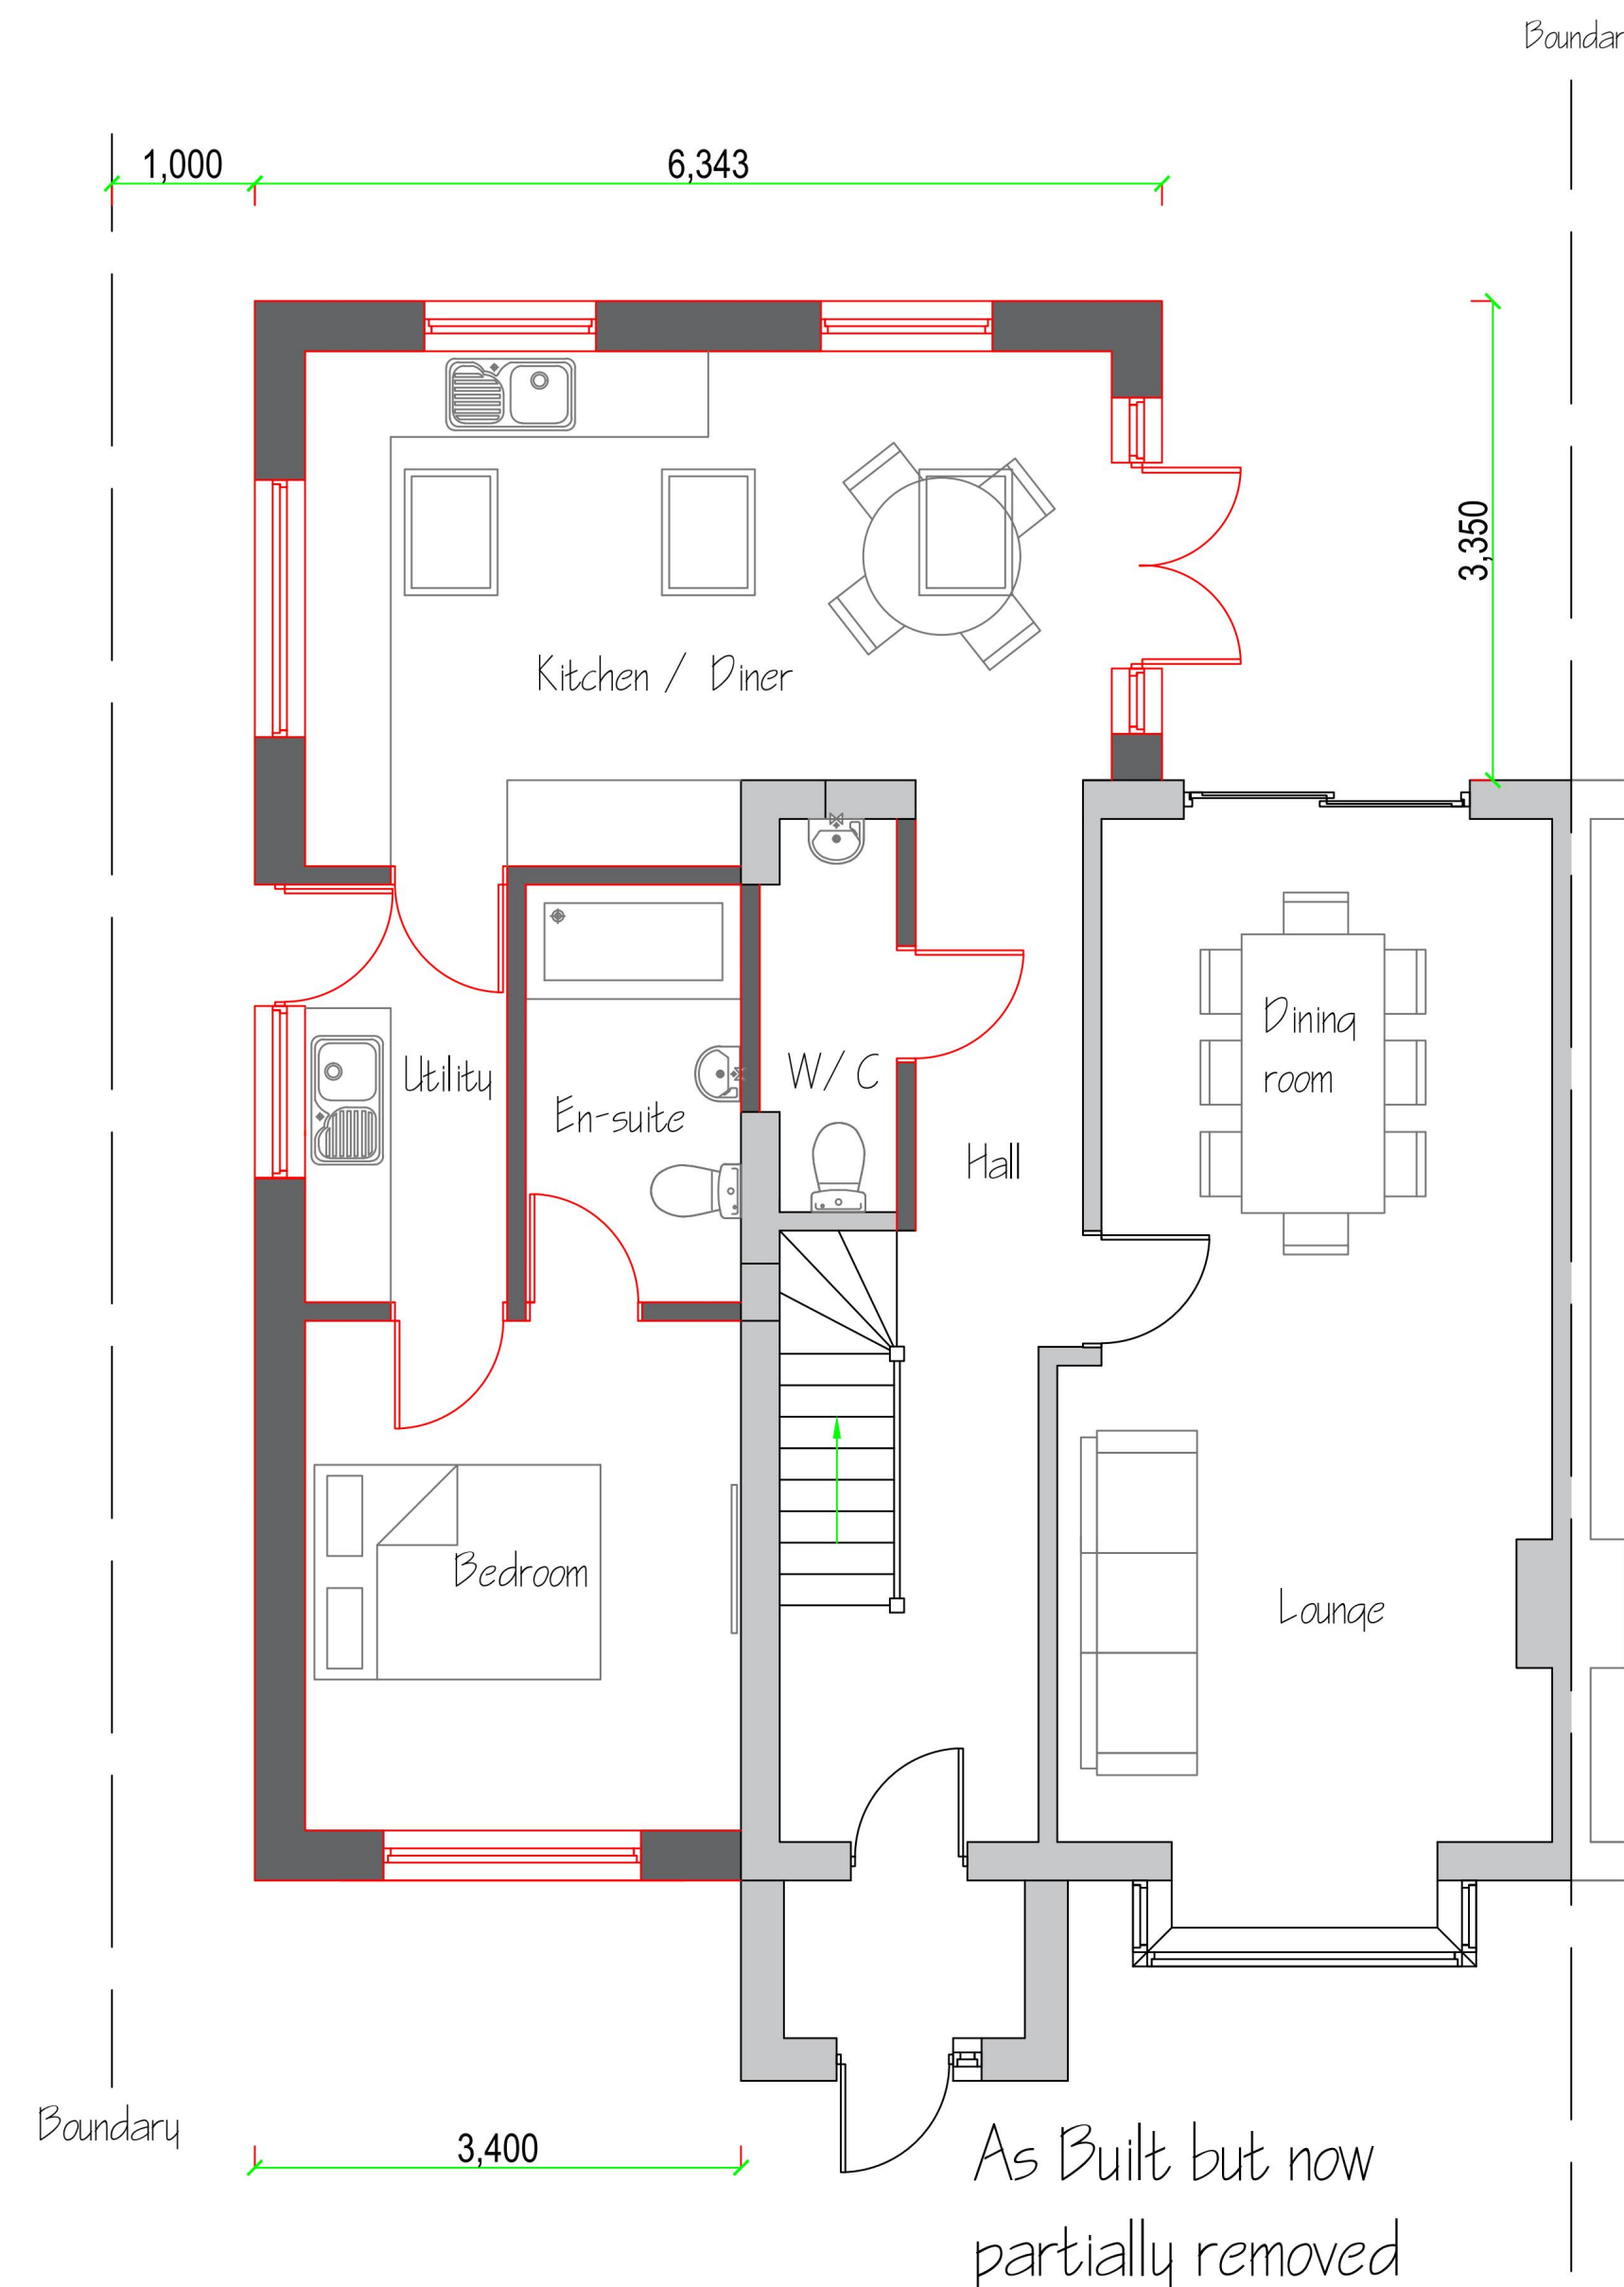
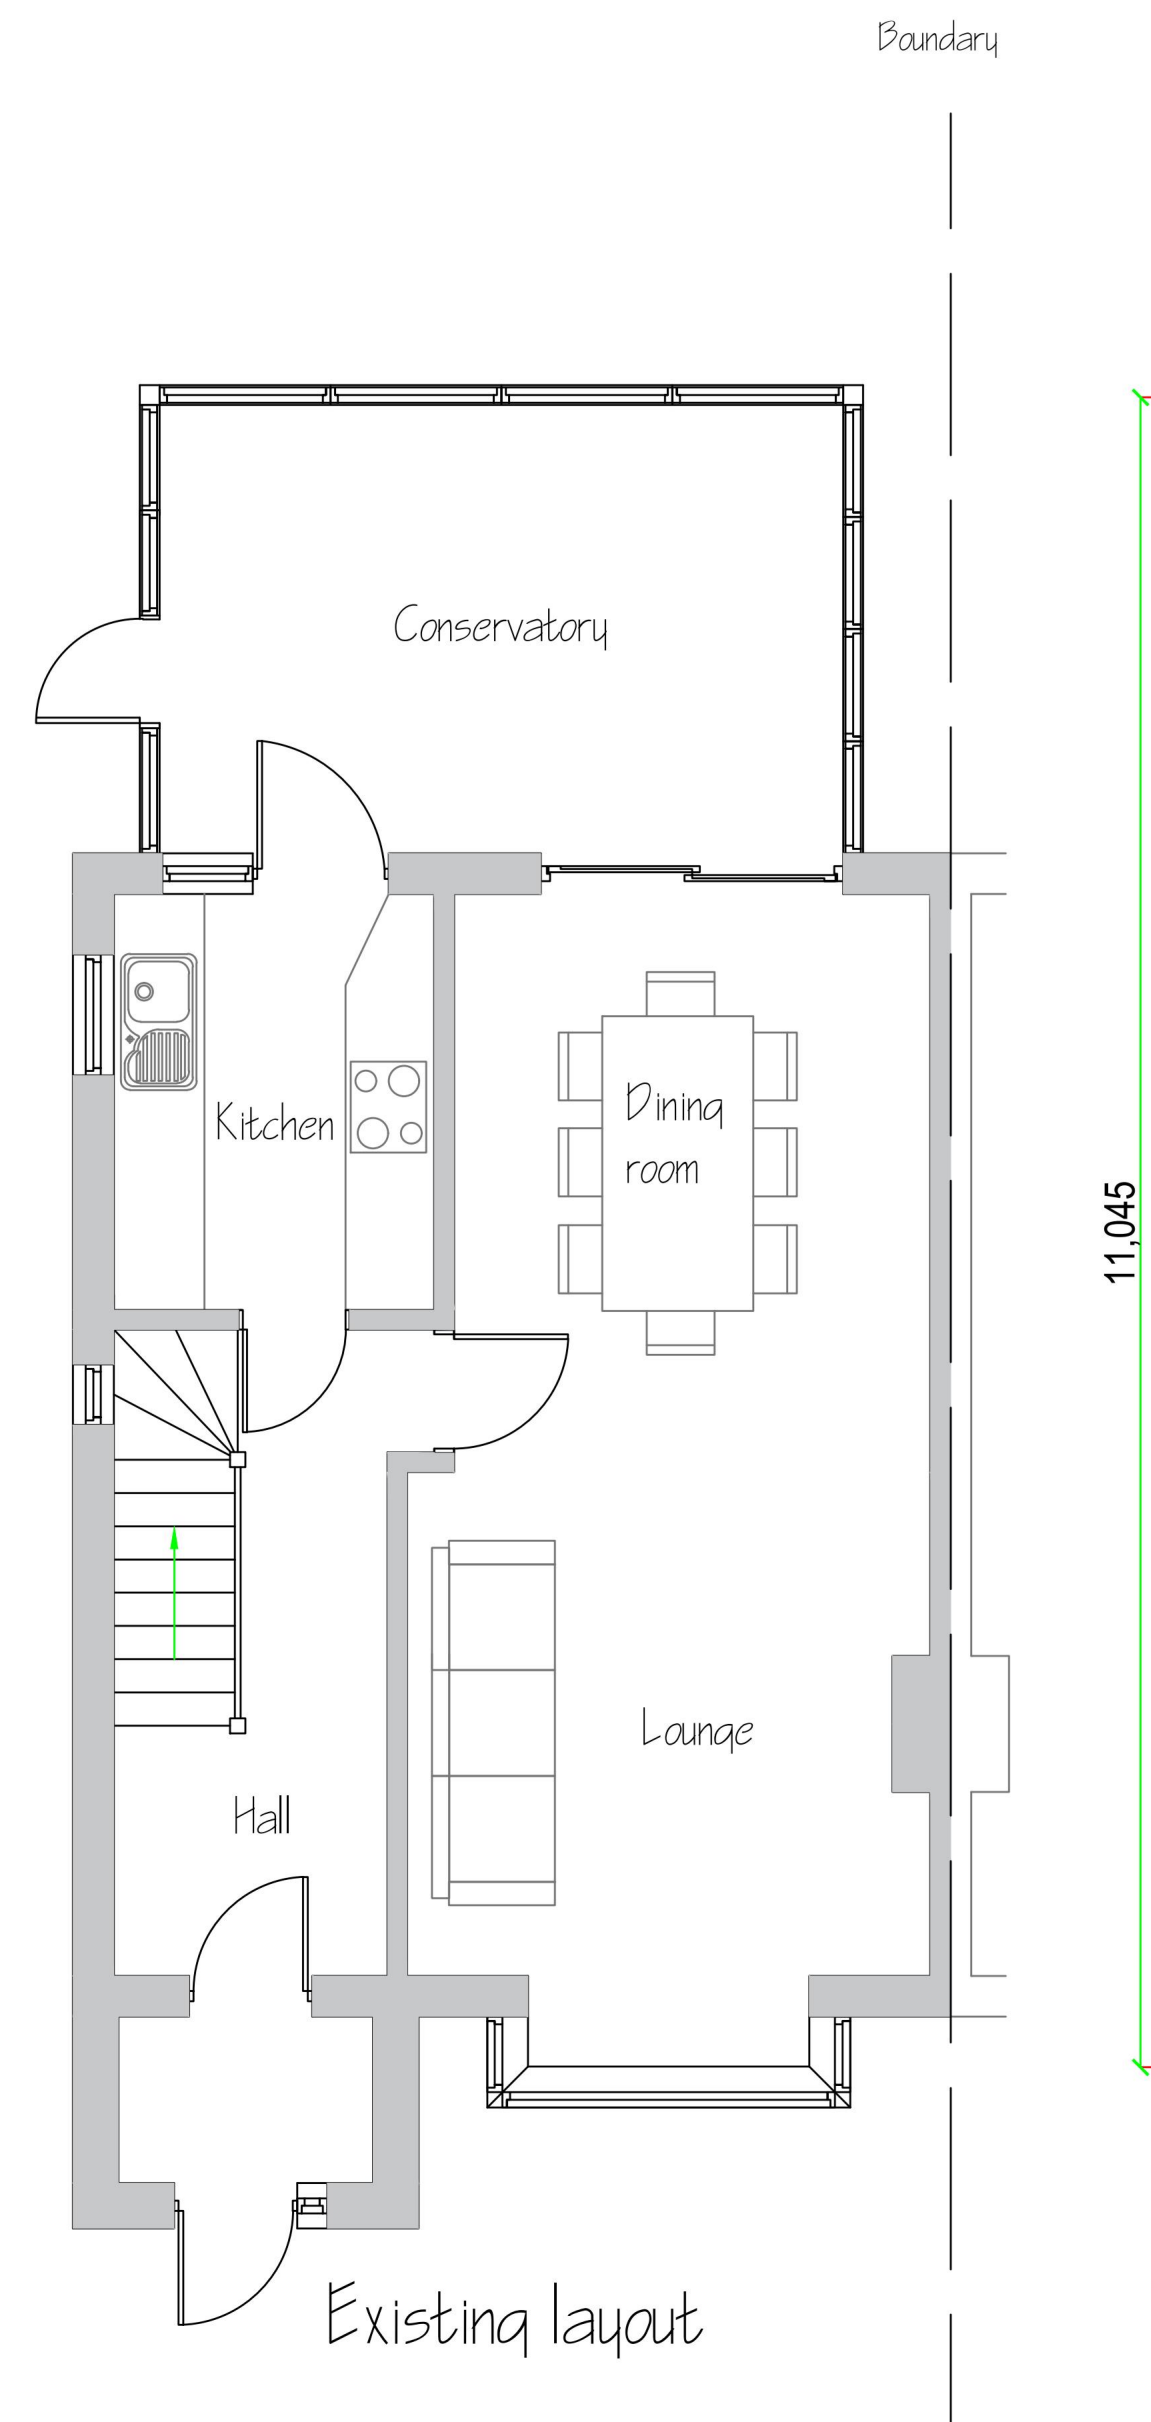
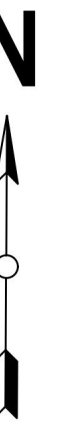
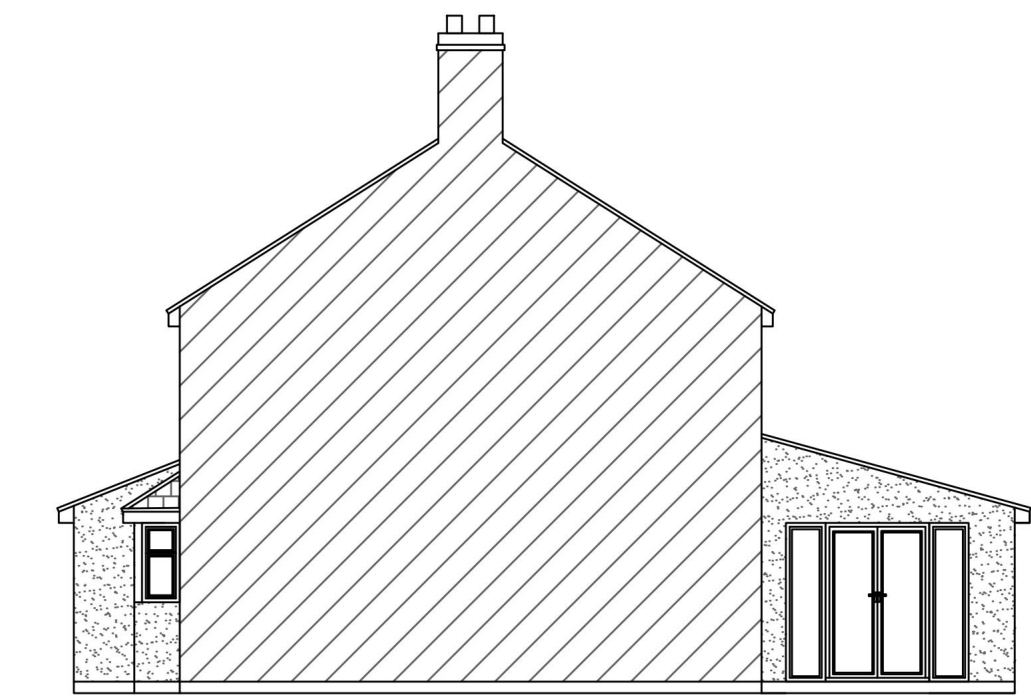
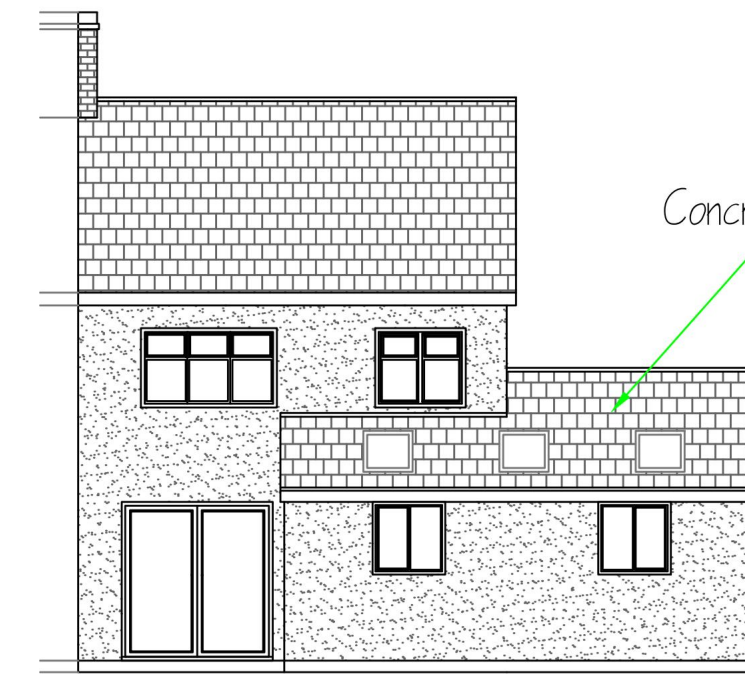
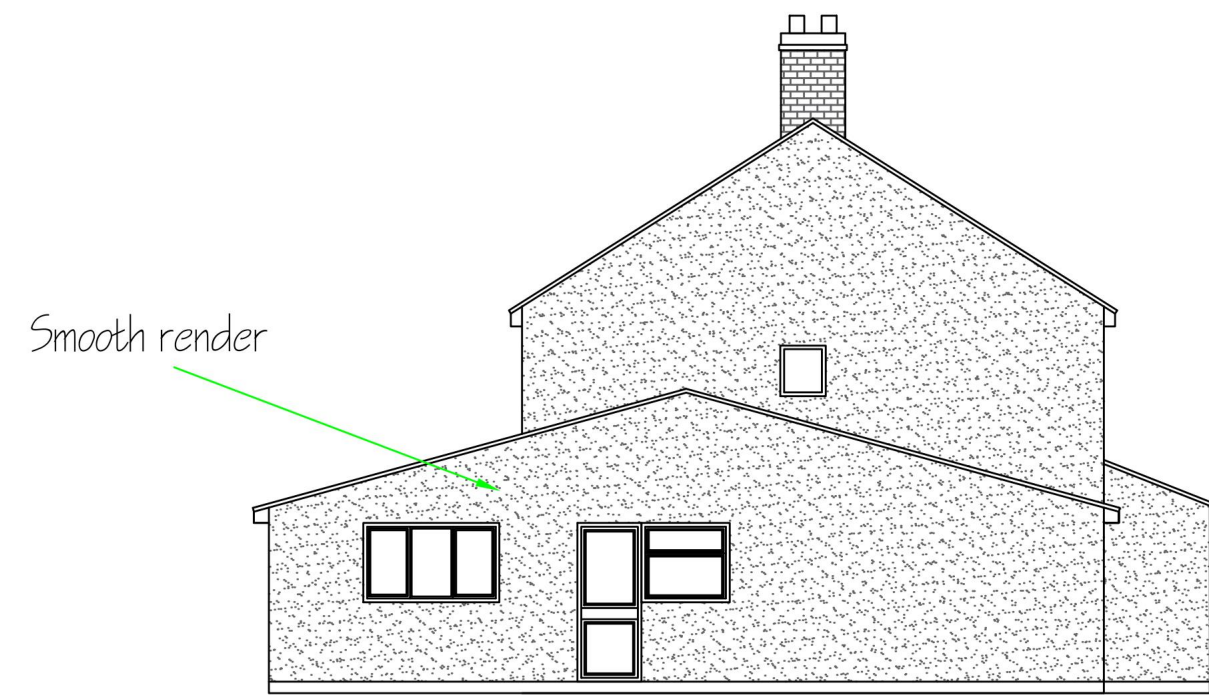
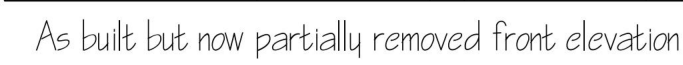


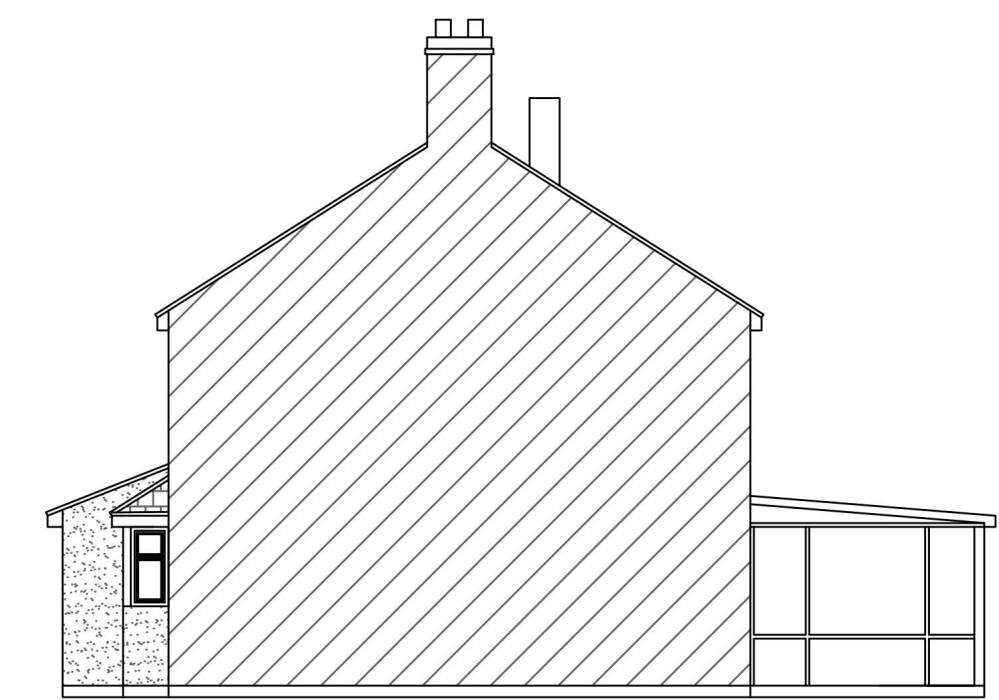

REV		223 Highfield Road Romford Greater London RM5 3AW	Existing / as Built but now removed Elevations And Layouts.
COPYRIGHT: This drawing is copyright and must not be reproduced without written consent. <u>All Measurements to be checked on-site.</u> <u>Do not scale from this drawing.</u>			Block Plan.
 Wright Ruffell Cameron LTD Architectural Design Service Beaver House Plough Road Centre Great Bentley Essex CO7 8LG Tel: 01206 250601 Fax: 01206 251443 e-mail: andy@wrcads.co.uk Web Site: wrcads.co.uk		Paper Size A1 SCALE 1:50, 1:100, 1:500 DATE 13/09/2023 PROJECT NO. 2535 DWG. NO. P03	DRAWN BY <i>Tony Wright</i> CHECKED BY Andy Cameron CIAT(Affiliate), OCDEA

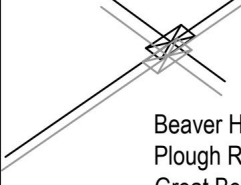


Existing front elevation

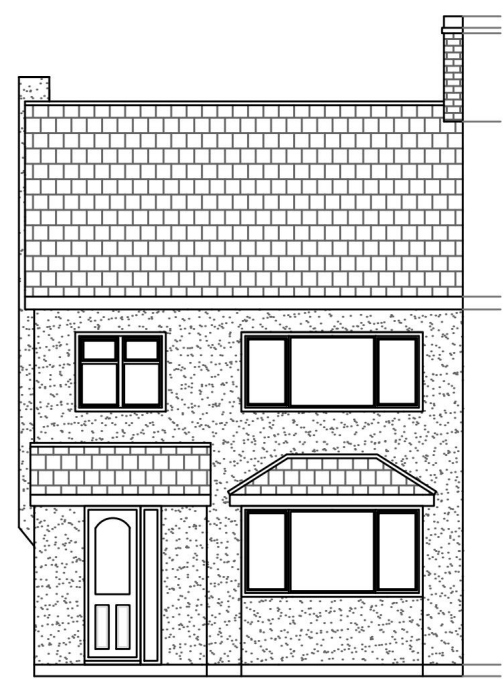

Existing side elevation




Existing rear elevation

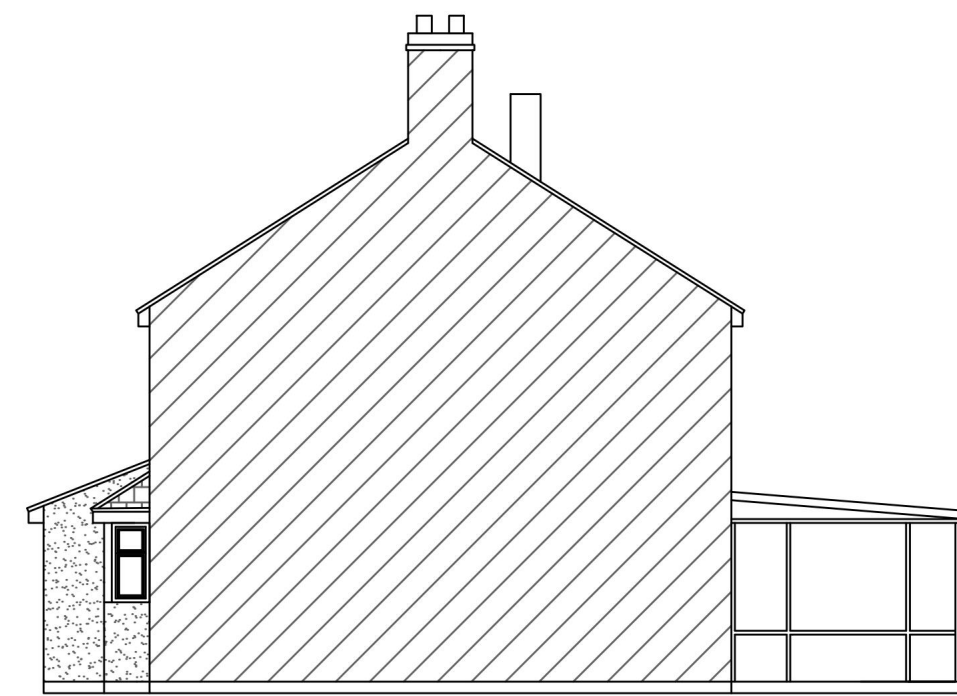


Existing side elevation




Proposed front elevation

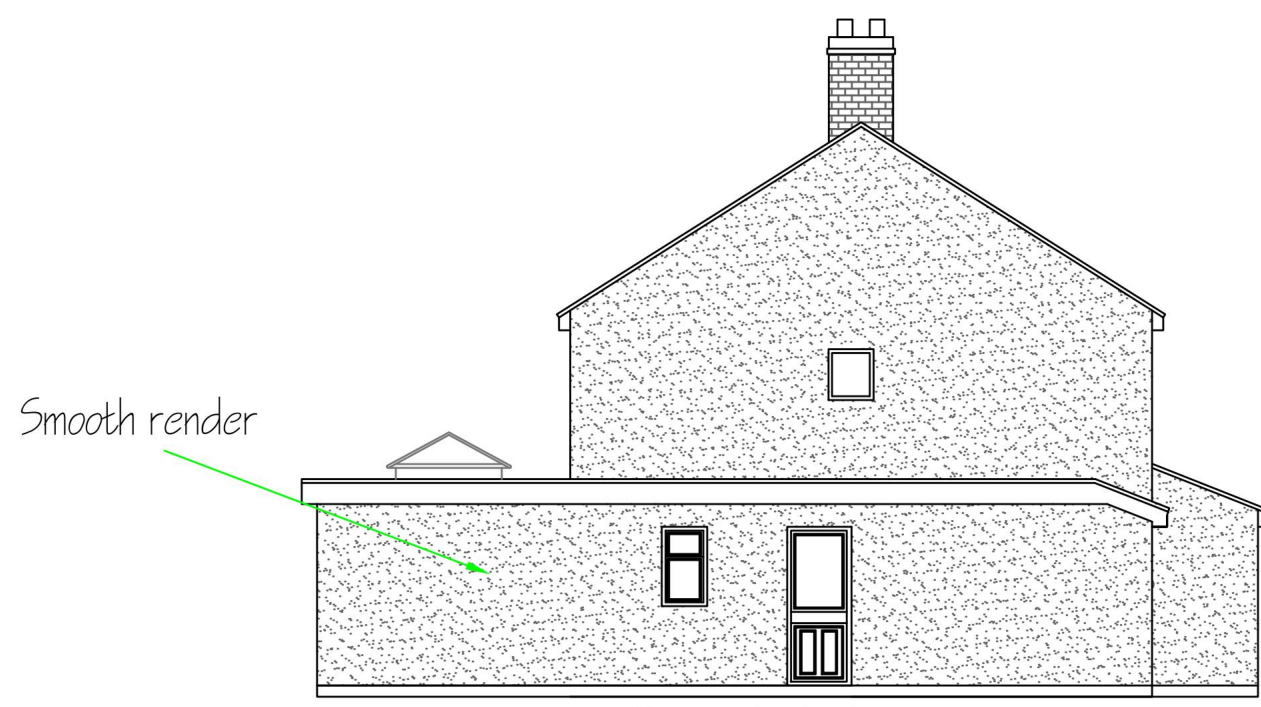


Proposed side elevation

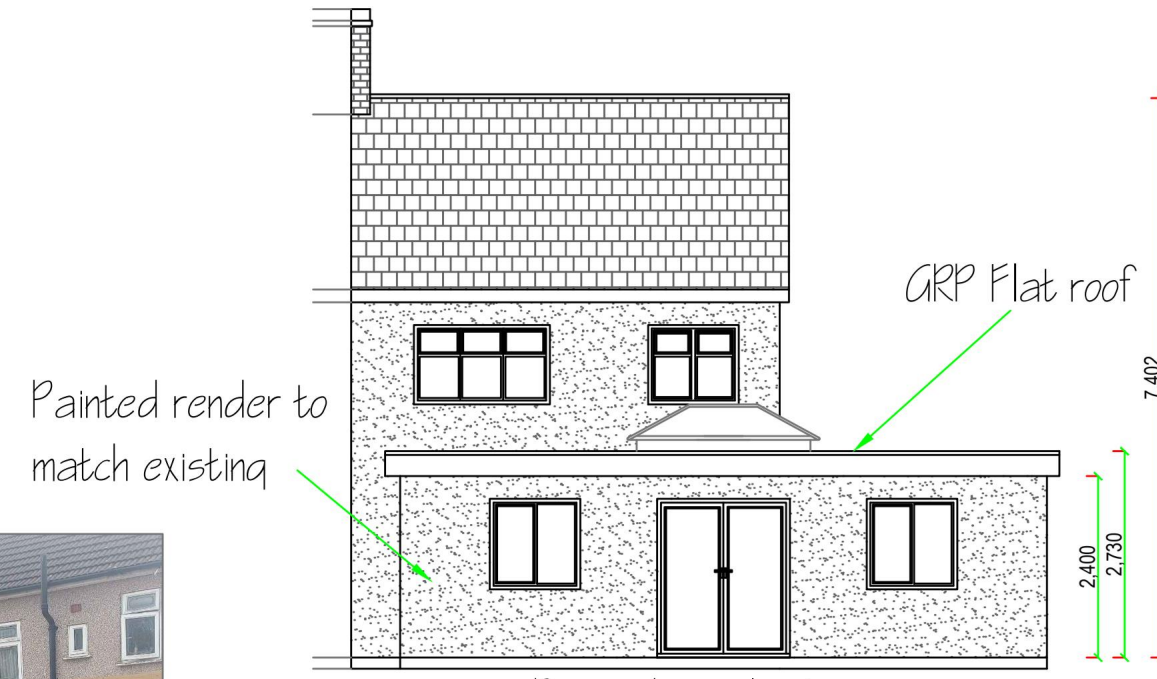


Proposed rear elevation

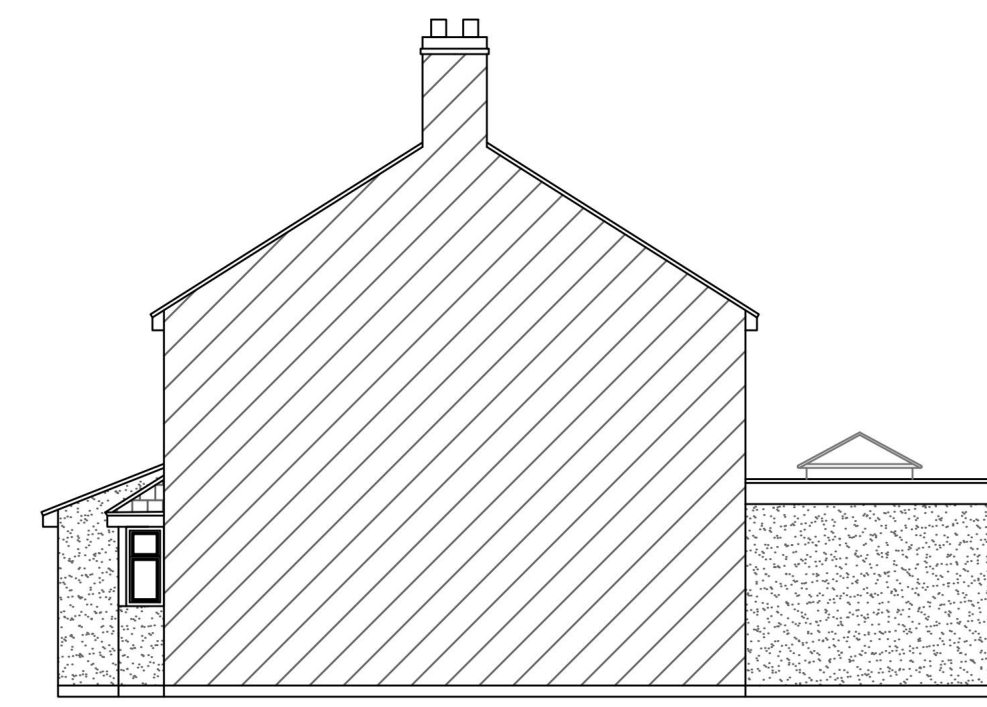


Proposed side elevation

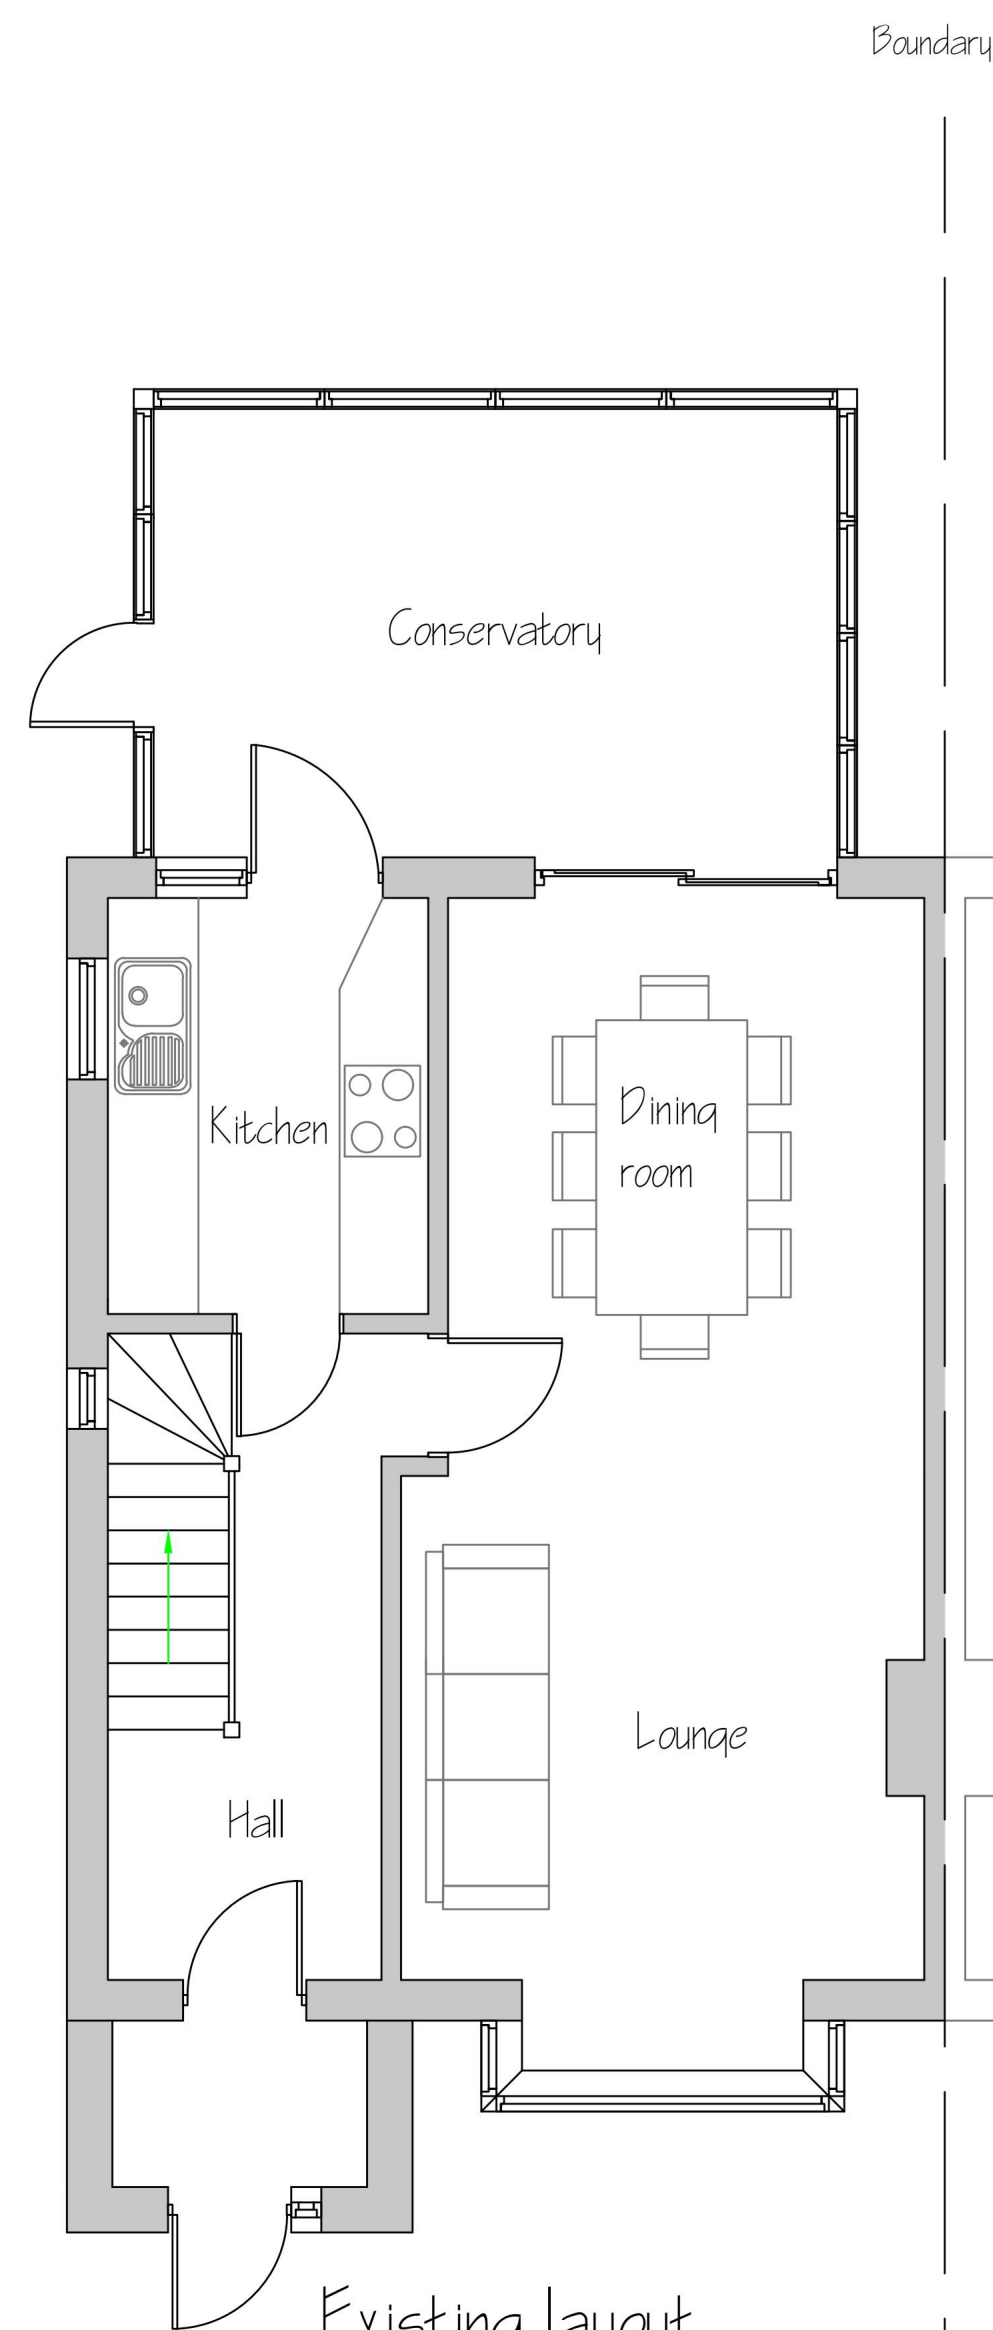


Existing layout

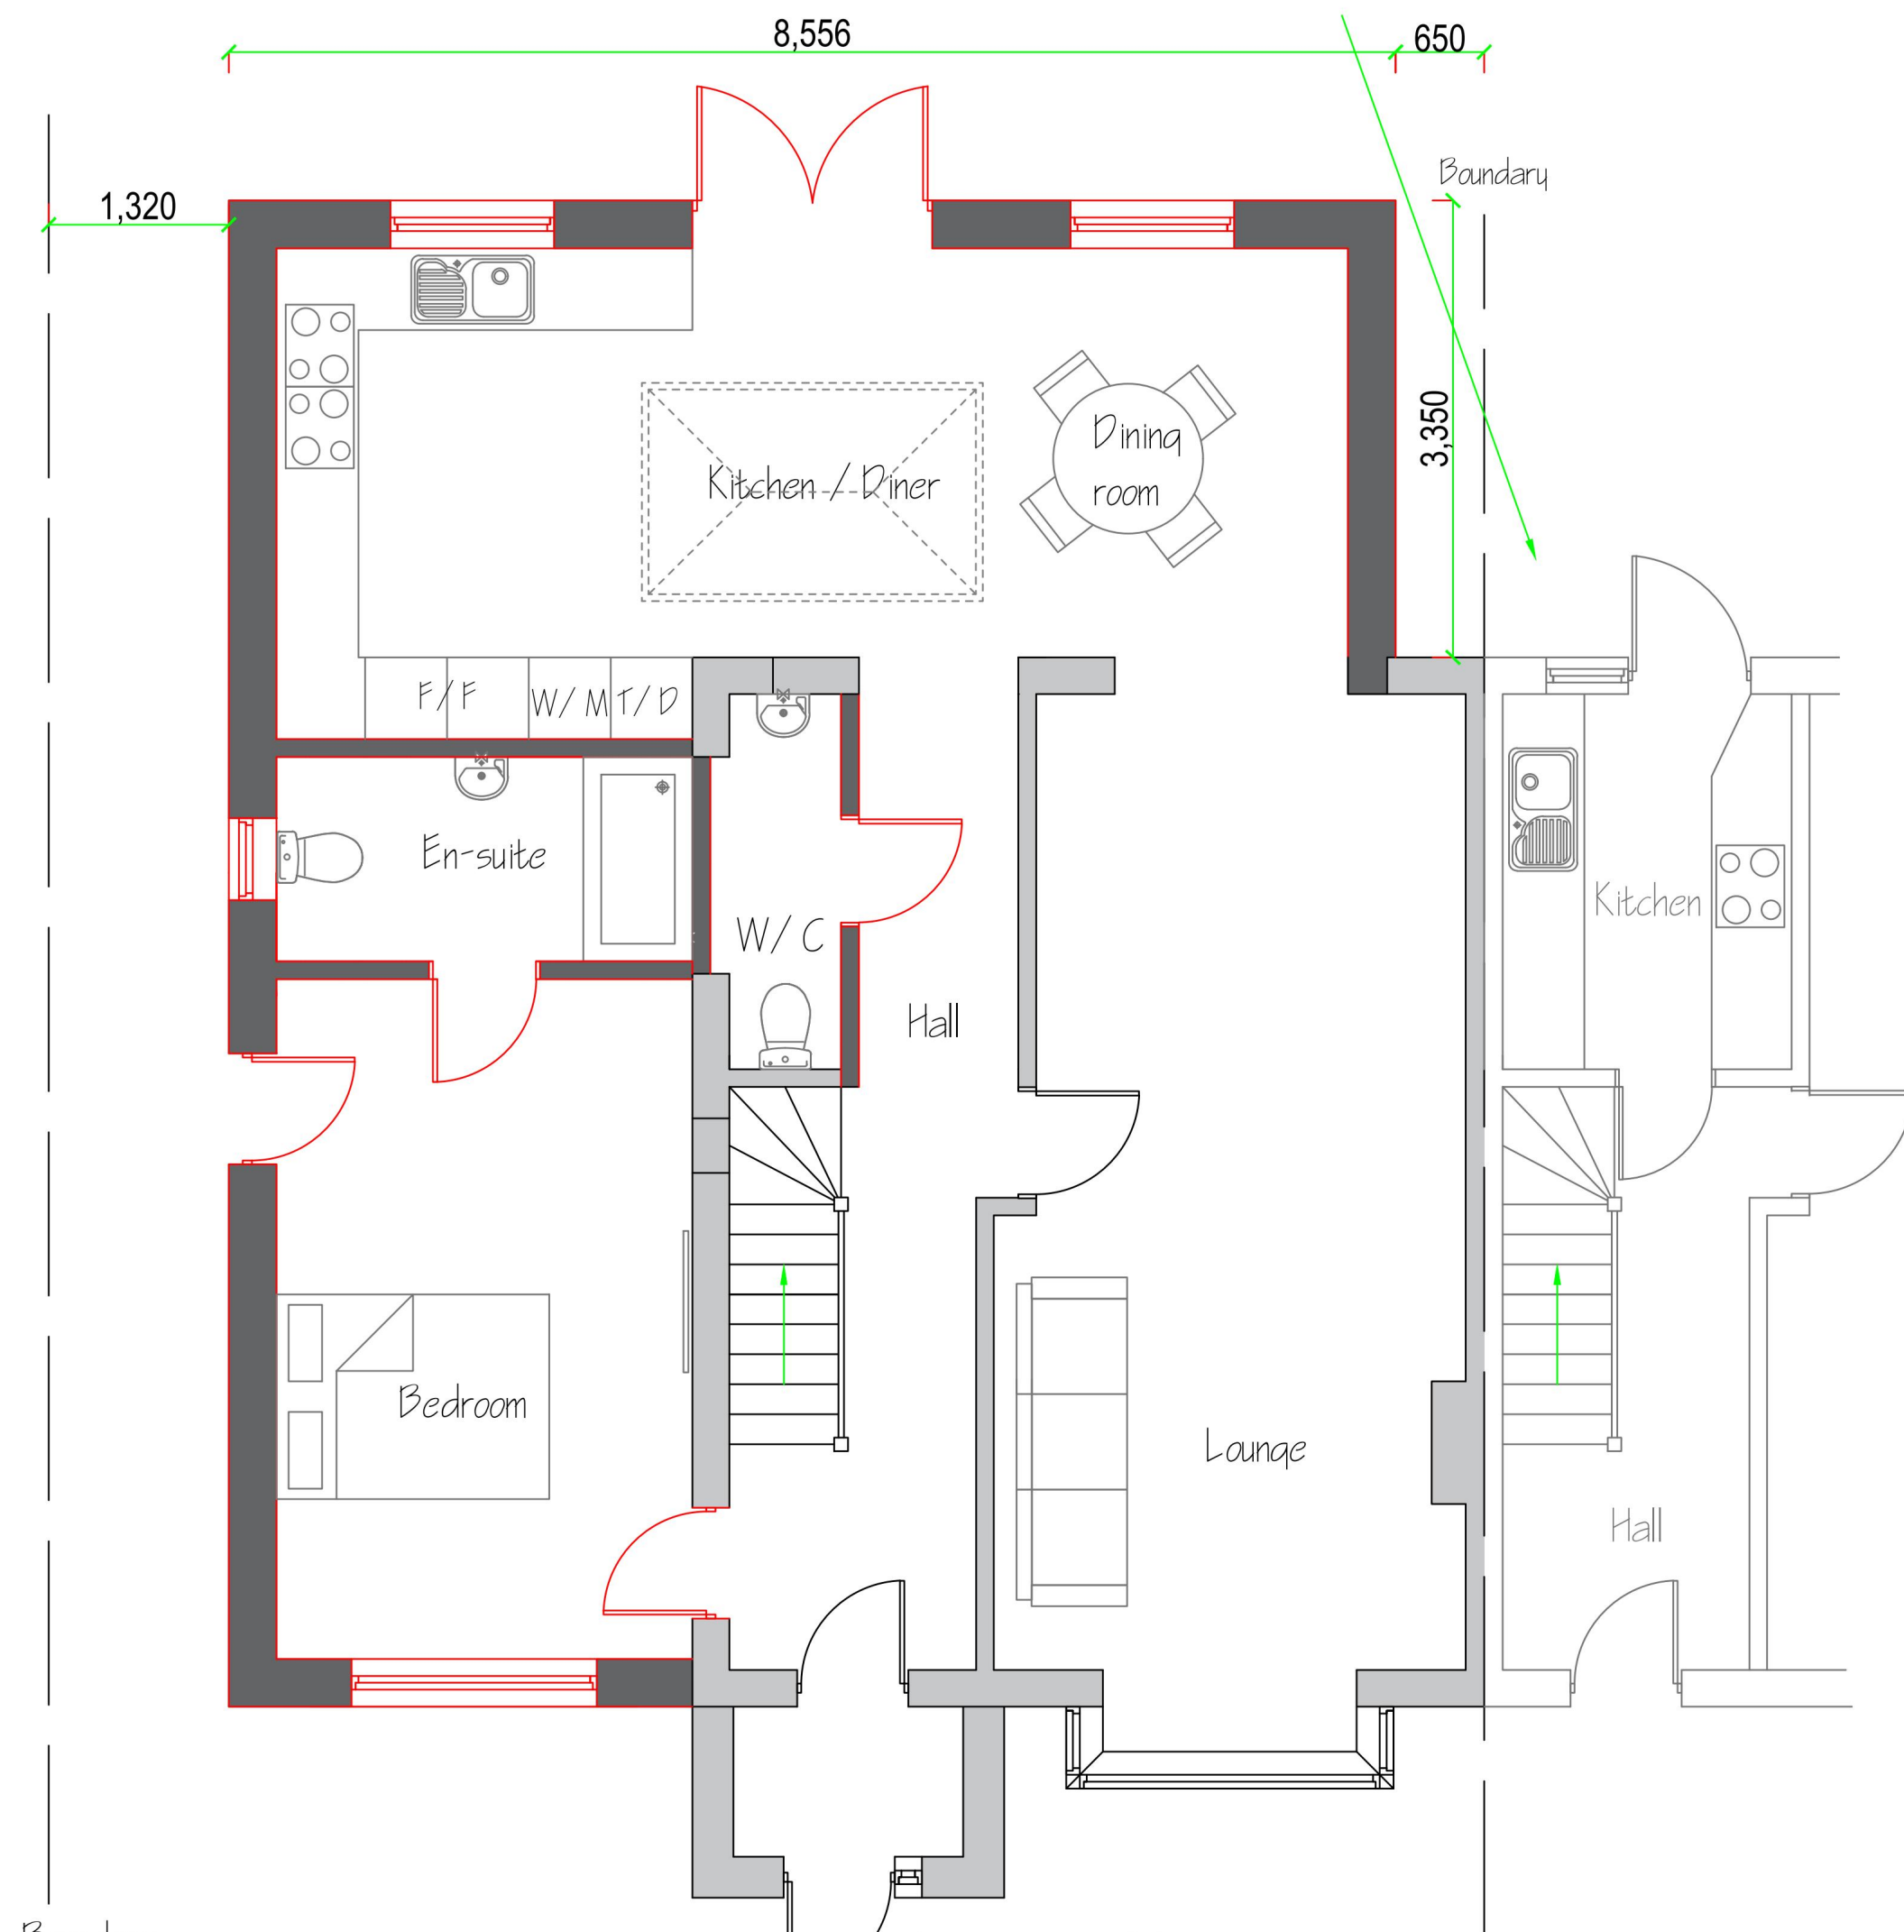

Proposed layout

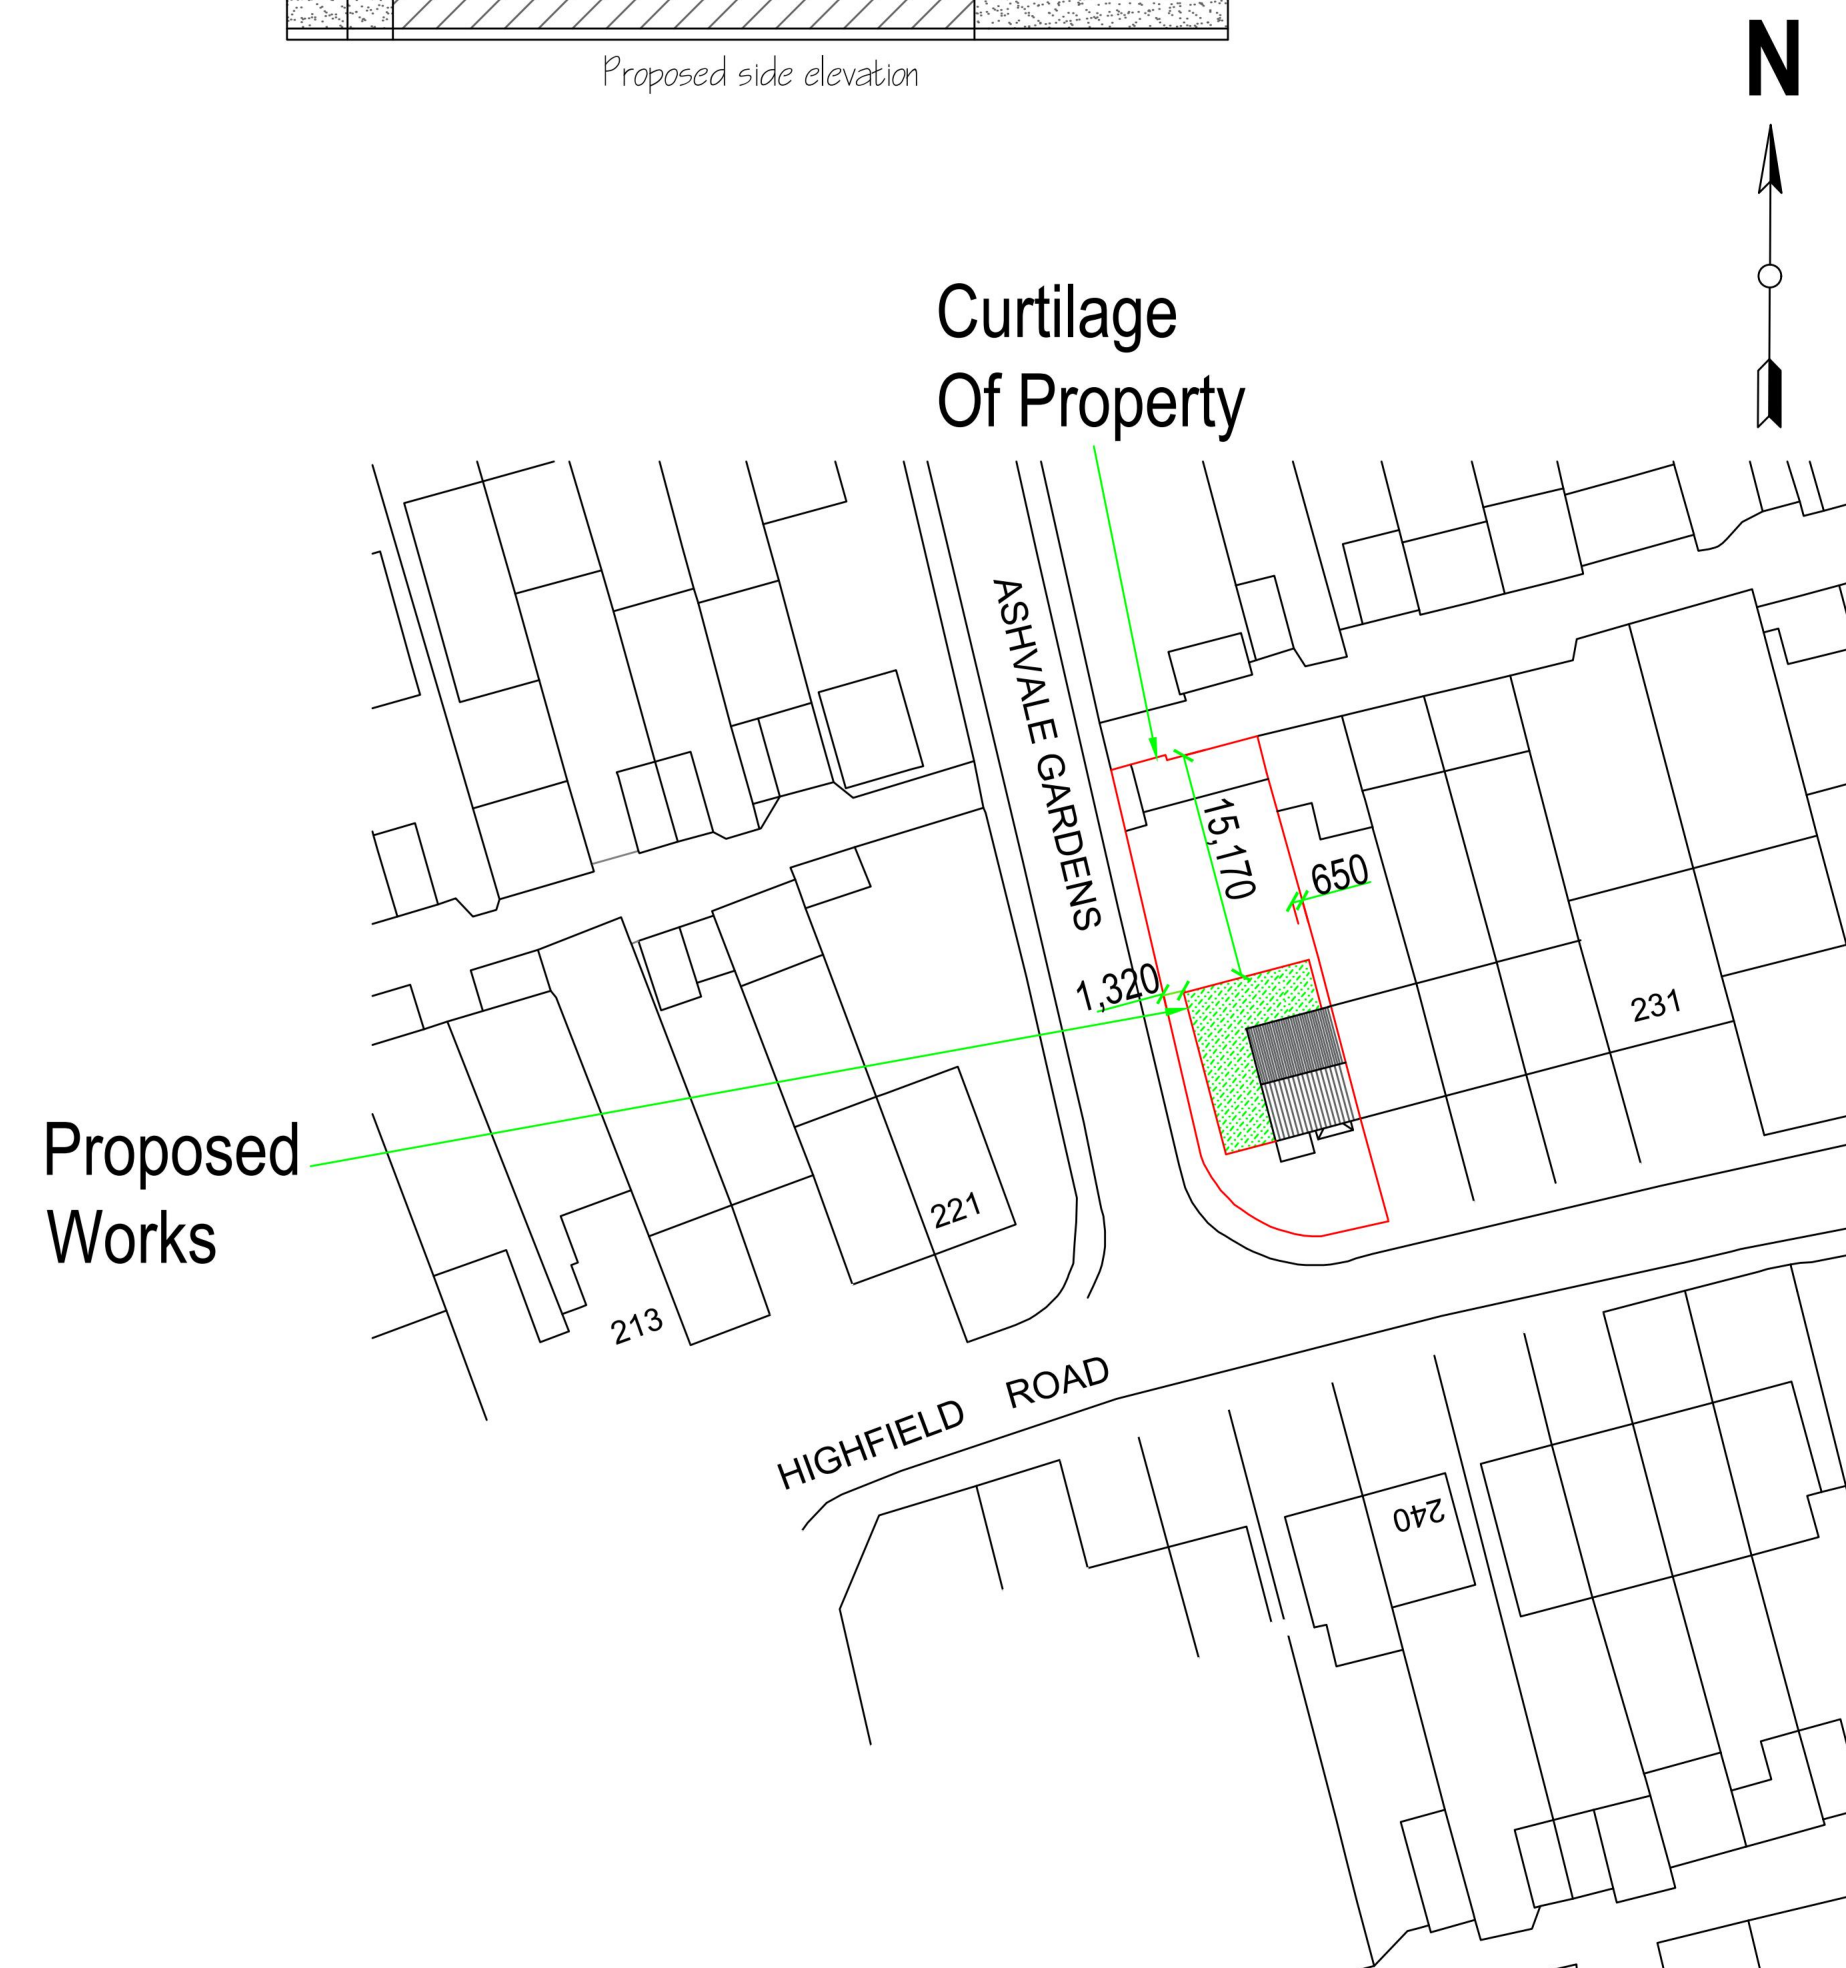

Block plan 1:500

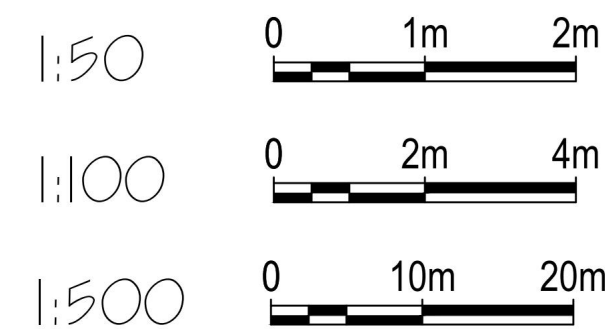

REV Rev 28/10/24 RDC P01c Alt for planning	223 Highfield Road Romford Greater London RM5 3AW	Existing / Proposed Elevations And Layouts. Block Plan.	Paper Size A1 SCALE 1:50,1:100,1:500 DATE 22/10/2024 PROJECT NO. 2535 DWG. NO. P01c	DRAWN BY Tony Wright
COPYRIGHT: This drawing is copyright and must not be reproduced without written consent. All Measurements to be checked on-site. Do not scale from this drawing.				CHECKED BY Andy Cameron CIAT(Affiliate), OCDEA
Wright Ruffell Cameron Architectural Design Service Beaver House Plough Road Centre Great Bentley Essex CO7 8LG Tel: 01206 250601 Fax: 01206 251443 e-mail: andy@wrcads.co.uk Web Site: wrcads.co.uk				