

	A	B	C	D	E	F	G	H	I	J		
1											PARTY WALL NOTICES: PLEASE NOTE THAT BEFORE BUILDING WORKS COMMENCES IT IS THE RESPONSIBILITY OF BUILDER OR OWNER TO SERVE PARTY WALL NOTICES TO ALL NEIGHBOURS	1
2											NOTE: DIMENSIONS: ALL DIMENSIONS TO BE CHECKED ON SITE. CONTRACTOR TO CHECK SITE THOROUGHLY BEFORE WORK STARTS & REPORT ANY DISCREPANCIES.	2
3											THIS DRAWING IS COPYRIGHT AND MUST NOT BE TRACED OR COPIED IN ANY WAY OR FORM IN PART OR WHOLE BY ANY MEANS WHATSOEVER WITHOUT PRIOR WRITTEN CONSENT AND MAY ONLY BE USED BY THE PRESENT OWNER IN RELATION TO THE PROPERTY AS REFERRED TO ON THE DRAWING. THIS DRAWING MAY BE COPIED BY AN AUTHORISED OFFICER OF THE LOCAL AUTHORITY WITH THE SOLE PURPOSE TO ASSIST IN THE DETERMINATION OF A PLANNING OR BUILDING REGULATIONS APPLICATION AND MAY NOT BE USED FOR ANY OTHER PURPOSE UNLESS OTHERWISE AGREED IN WRITING.	3
4											DIMENSIONS STATED ARE FOR GUIDANCE ONLY, CONTRACTOR TO VERIFY ALL BOUNDARY POSITIONS AND DIMENSIONS ON SITE PRIOR TO COMMENCING ANY WORKS, MAKING WORKSHOP DRAWINGS OR OBTAINING ANY MATERIALS.	4
5											NOTE: NO CHECK DIMENSIONS OF THE SITE HAVE BEEN TAKEN AND ALL INFORMATION AND DETAILS HAVE BEEN PROVIDED BY THE CLIENT.	5
6											NO SITE SUPERVISION IS IMPLIED OR UNDERTAKEN UNLESS OTHERWISE SEPARATELY ARRANGED. THE DRAWING DOES NO INDICATE THE EXTENT OF ANY EXCAVATION WORKS AND THE CONTRACTOR IS TO DETERMINE THIS PRIOR TO SUBMITTING A QUOTATION FOR THE WORKS OR COMMENCING ANY WORKS.	6
7											THE DRAWING DOES NOT INDICATE OR IMPLY THE STRUCTURAL CONDITION OF THE EXISTING PROPERTY. THE DRAWINGS HAVE BEEN PREPARED FOR ASSISTANCE IN THE PREPARATION OF DETAILS FOR PLANNING AND BUILDING REGULATIONS PURPOSES ONLY. NO CHECK DIMENSIONS HAVE BEEN TAKEN, ALL DETAILS HAVE BEEN PROVIDED BY THE CLIENT.	7
8											THE USE OF PERMITTED DEVELOPMENT RIGHT IN PROPERTY IS SUBJECT TO INFORMATION PROVIDED BY OWNER REGARDING THE STATUS OF PROPERTY AS A DWELLING HOUSE AND THE DWELLING NOT BEING IN A CONSERVATION AREA. ANY DEVELOPMENT WITH OUT A CERTIFICATE OF LAWFULNESS OR PLANNING PERMISSION IS SOLELY AT OWNER'S RISK.	8
	A	B	C	D	E	F	G	H	I	J		

PRE-EXISTING OUT-BUILDING PLAN		PRE-EXISTING (OUT-BUILDING) ROOF PLAN	

PRE-EXISTING FRONT ELEVATION		PRE-EXISTING SIDE ELEVATION-01	

PRE-EXISTING FRONT ELEVATION		PRE-EXISTING SIDE ELEVATION-02	

Metres	

A	260925	AA		FIRST ISSUE
ISSUE	DATE	INITIALS	GRID REF	DESCRIPTION

104 OAKS LANE
NEWBURY PARK
ILFORD, ESSEX
IG2 7PX
Mob. 079 0386 5705
Off. 020 3983 4205
info@livarch.co.uk
www.livarch.co.uk


PROJECT	
54 HULSE AVENUE ROMFORD RM7 8NT	

DWG TITLE	
PRE-EXISTING PLAN – ELEVATIONS ROOF PLAN	


CLIENT	
MR. INDERVIR SINGH	

DWG NO:		ISSUE
LIVARCH/54HA/101		A


SCALE	DATE	DRAWN BY
1:100	26 SEP	AA

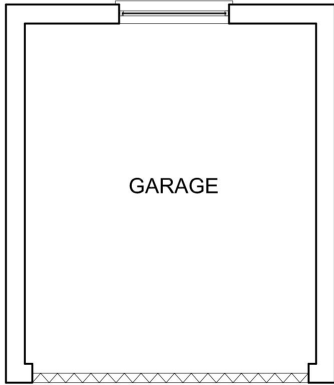


PRE-EXISTING
OUT-BUILDING PLAN

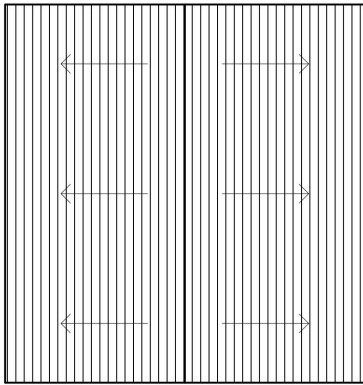


PRE-EXISTING (OUT-BUILDING)
ROOF PLAN

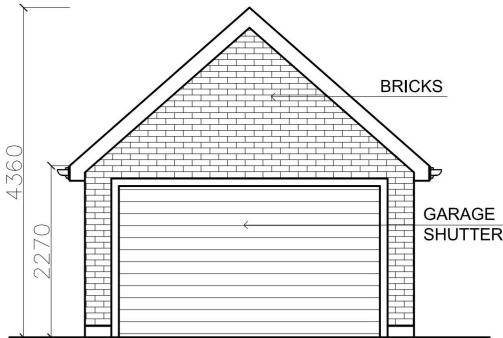


PRE-EXISTING
FRONT ELEVATION

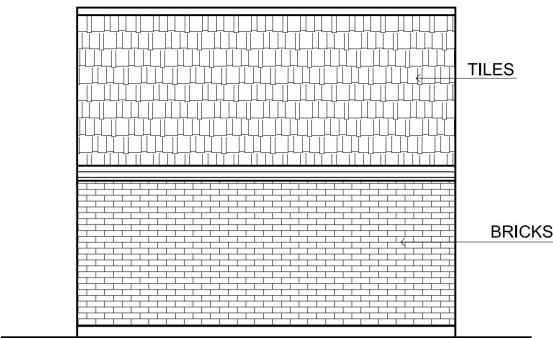

PRE-EXISTING
SIDE ELEVATION-01

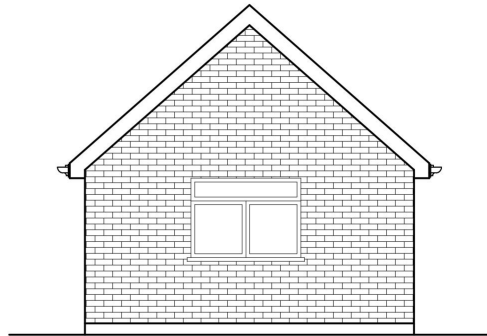


PRE-EXISTING
FRONT ELEVATION

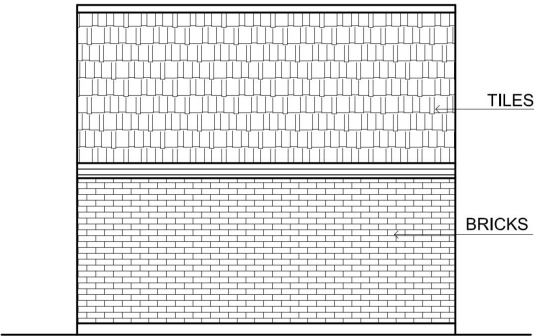


PRE-EXISTING
SIDE ELEVATION-02


	A	B	C	D	E	F	G	H	I	J	
1											<

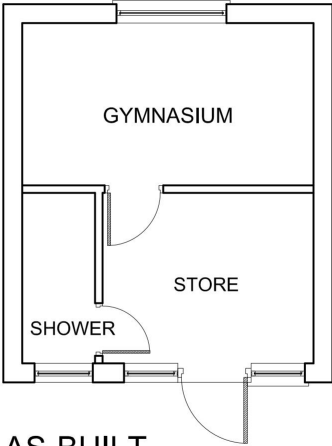


AS-BUILT
OUT-BUILDING PLAN

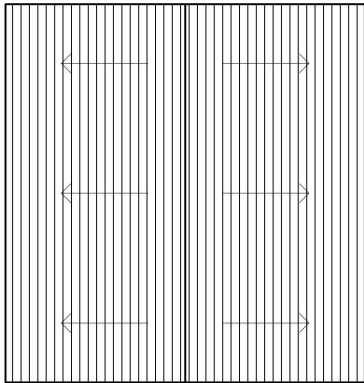


AS-BUILT (OUT-BUILDING)
ROOF PLAN

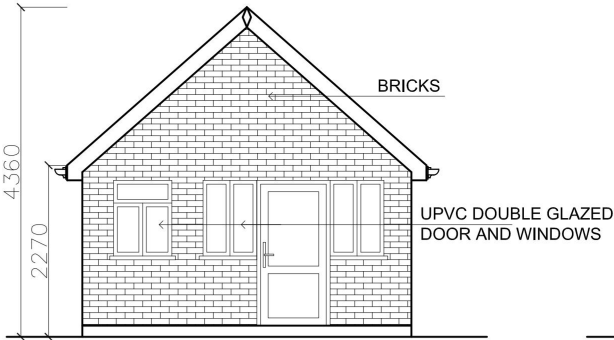


AS-BUILT
FRONT ELEVATION

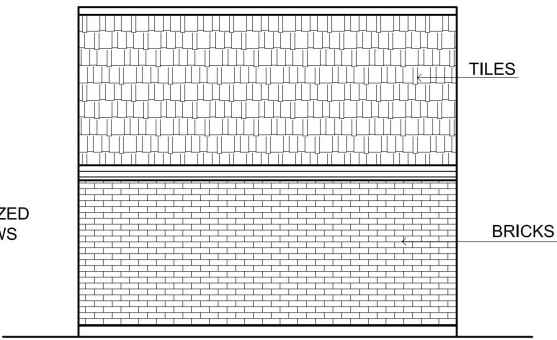

AS-BUILT
SIDE ELEVATION-01

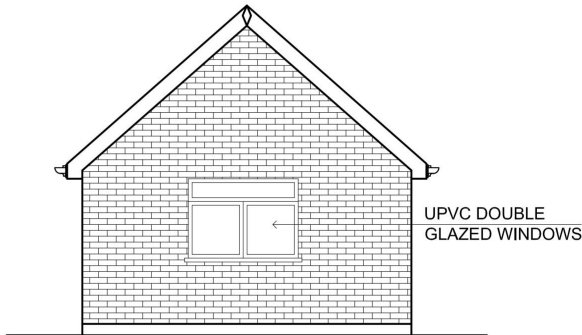

AS-BUILT
FRONT ELEVATION

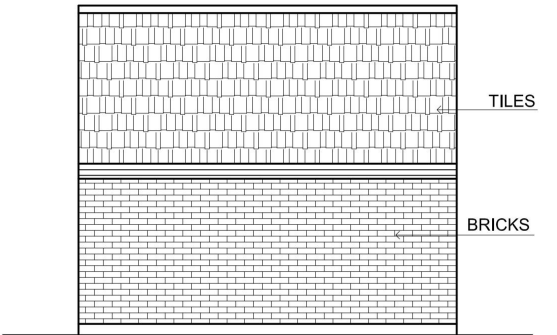

AS-BUILT
SIDE ELEVATION-02

