


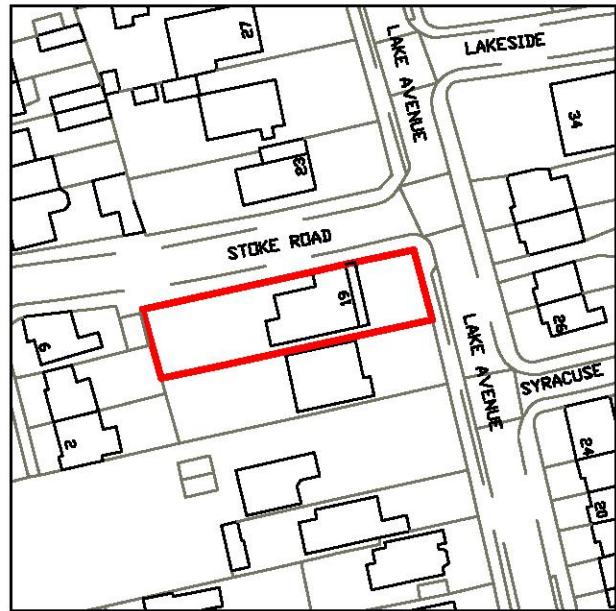


20000 0 20000 40000 60000 80000 100000
Millimetres

© Crown copyright and database rights 2019 OS 100035409

Reproduction in whole or in part is prohibited
without the permission of Ordnance Survey.

Scale: 1:1250

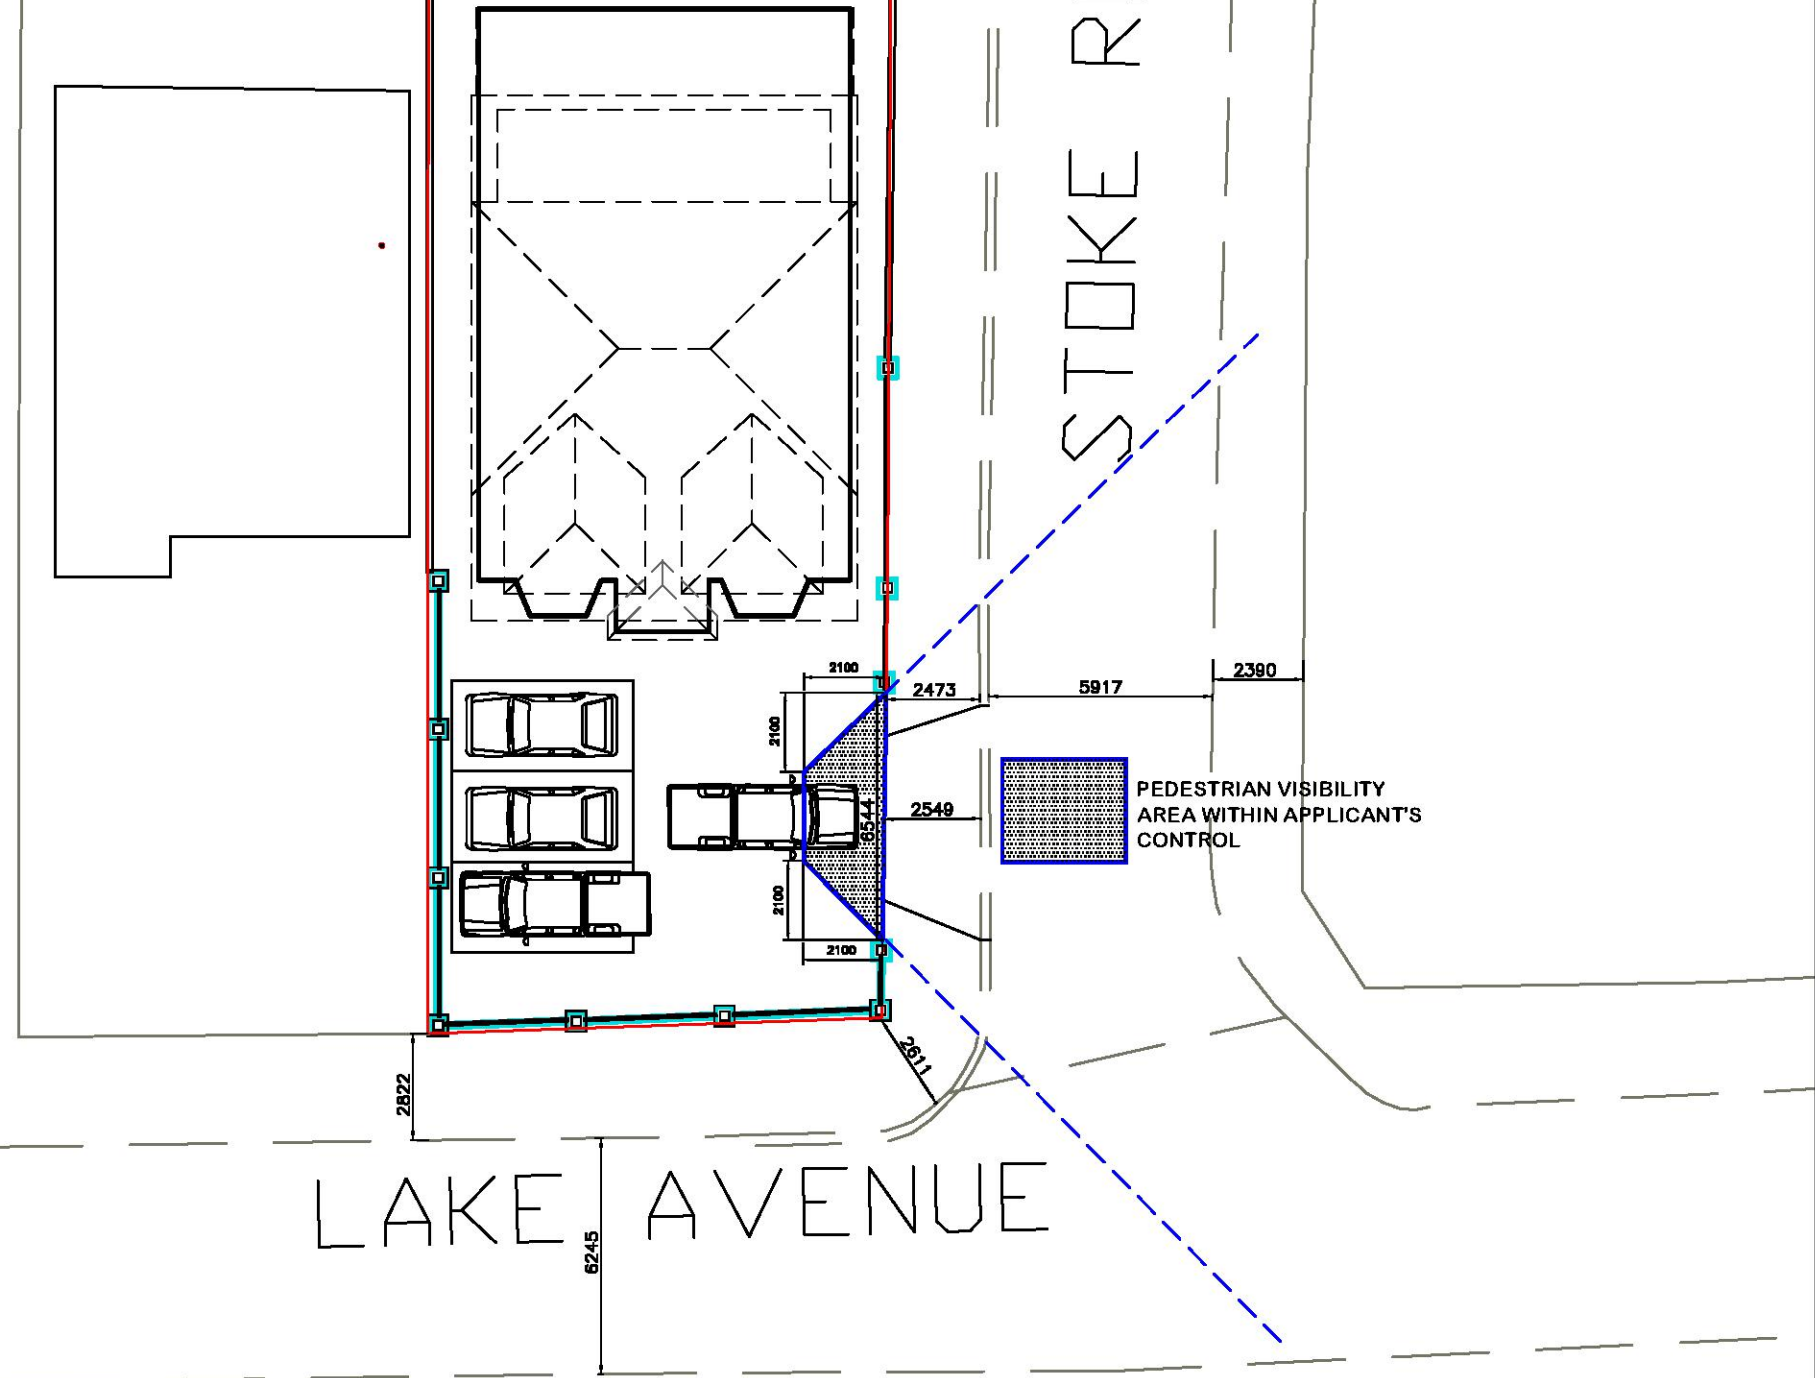

General Notes: All dimensions in mm unless specified otherwise | Contractors to confirm all dimensions on site



City Landmark Designs
(Planning, Appeals, Architectural, Calculations, Building Construction & Management)

1 Beadles Parade, Rainham Road South, Dagenham, Essex, RM10 8YL
Tel: 0208 593 2929 Mob: 07983 965 580
Email: info@citylandmark.net
Website: www.citylandmark.net

Proposed development:

Retention of front porch hip roof, bay windows, and other external alterations. Retention of rear garden outbuilding for gym purpose including bathroom, and boundary fence and crossover

Site location:

19 Lake Avenue
Rainham

Drawing No: 10b

Scale: 1:200 @ A3

Date: Dec 2020




APPROVED FRONT ELEVATION



APPROVED SIDE ELEVATION



APPROVED REAR ELEVATION

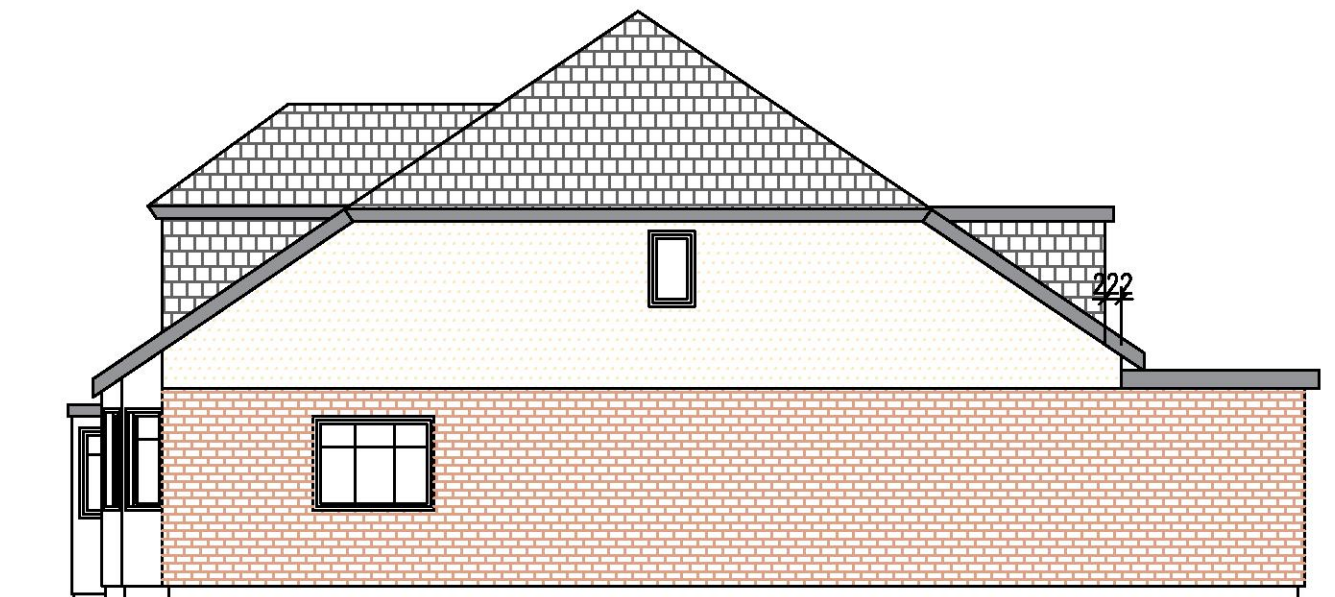

APPROVED SIDE ELEVATION

General Notes: All dimensions in mm unless specified otherwise | Contractors to confirm all dimensions on site



CITY LANDMARK DESIGNS LIMITED

City Landmark Designs
(Planning, Appeals, Architectural, Calculations, Building Construction & Management)

1 Beadles Parade, Rainham Road South, Dagenham, Essex, RM10 8YL
Tel: 0208 593 2929 Mob: 07983 965 580
Email: info@citylandmark.net
Website: www.citylandmark.net

Proposed development:

Retention of front porch hip roof, bay windows and other external alterations. Retention of rear garden outbuilding for gym purpose including bathroom.


Site location:

19 Lake Avenue
Rainham


Drawing No: 05

Scale: 1:100 @ A3


Date: Oct 2020

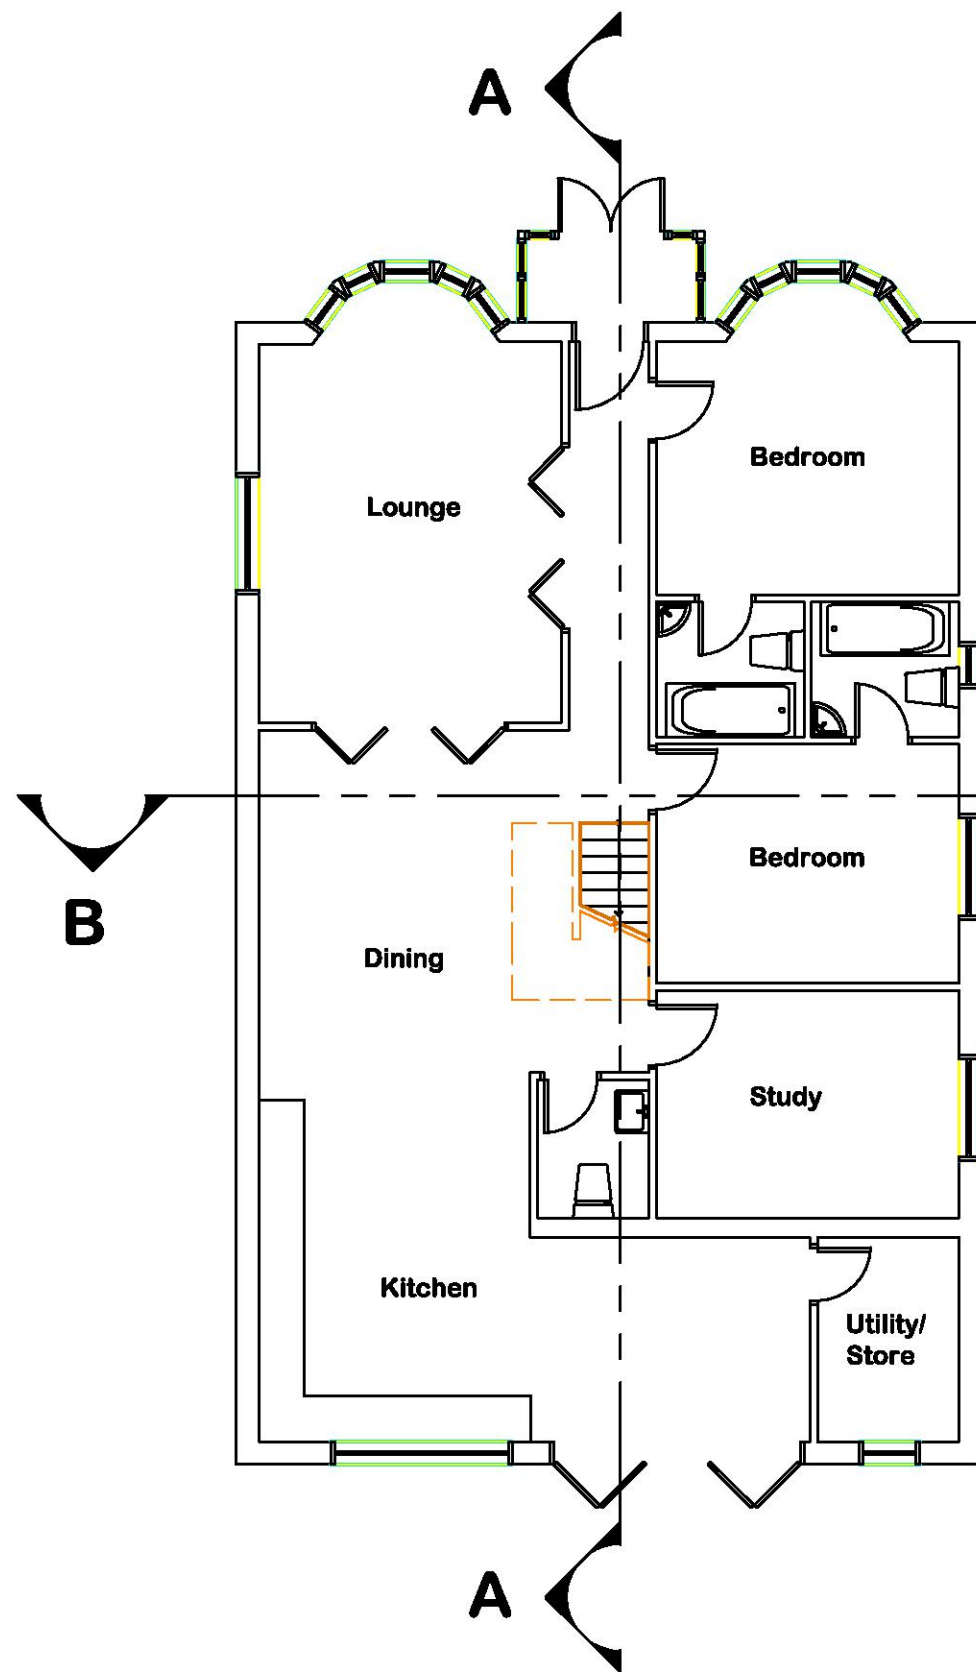

APPROVED GROUND FLOOR PLAN

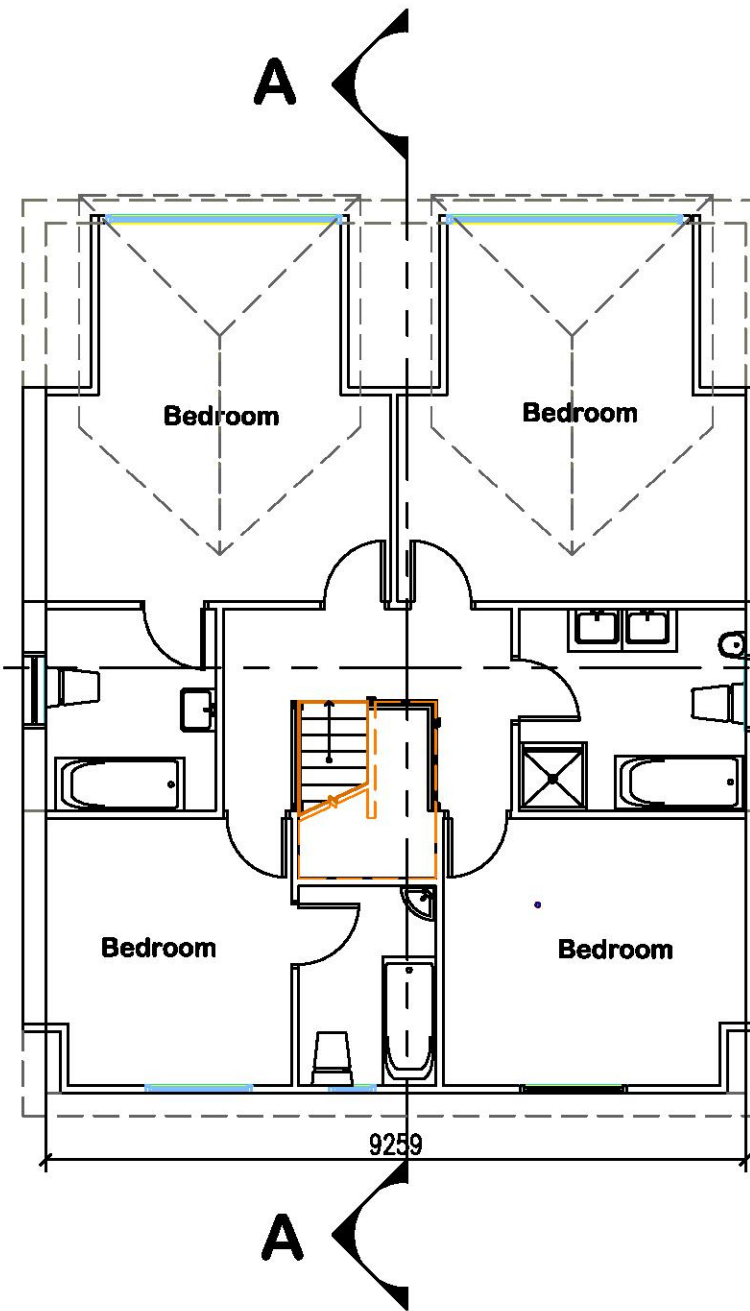

APPROVED FIRST FLOOR PLAN

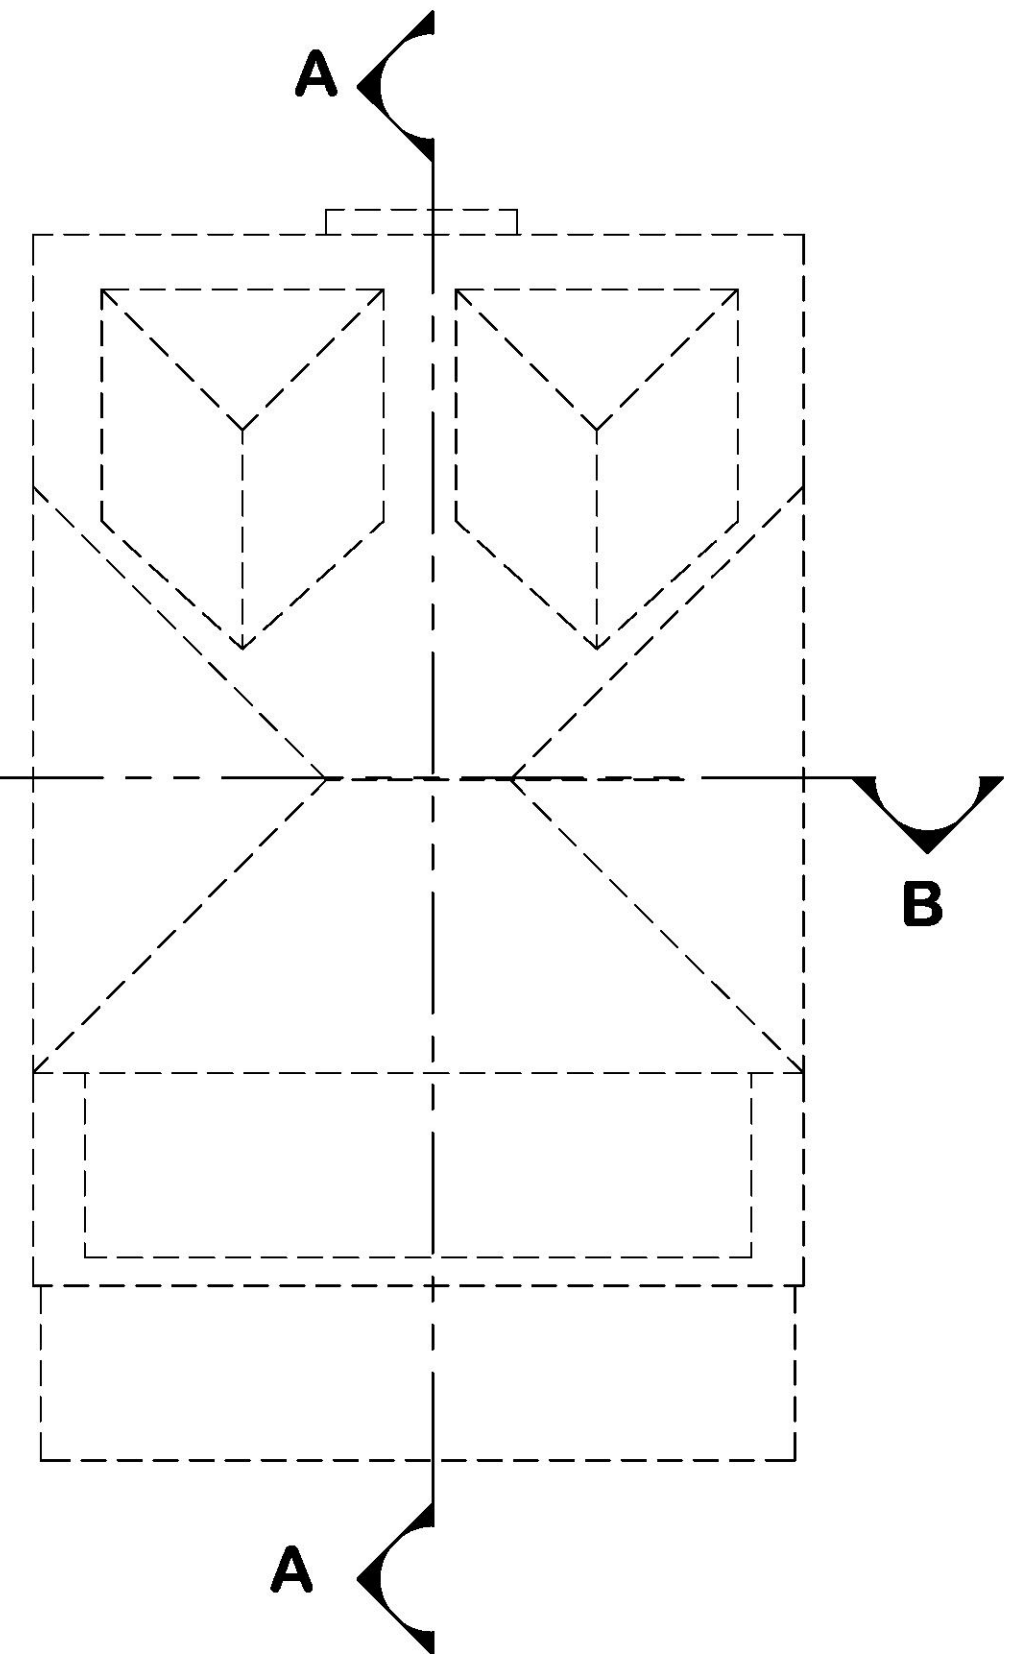

APPROVED ROOF FLOOR PLAN

General Notes: All dimensions in mm unless specified otherwise | Contractors to confirm all dimensions on site



CITY LANDMARK DESIGNS LIMITED

City Landmark Designs
(Planning, Appeals, Architectural, Calculations, Building Construction & Management)

1 Beadles Parade, Rainham Road South, Dagenham, Essex, RM10 8YL
Tel: 0208 593 2929 Mob: 07983 965 580
Email: info@citylandmark.net
Website: www.citylandmark.net

Proposed development:

Retention of front porch hip roof, bay windows and other external alterations. Retention of rear garden outbuilding for gym purpose including bathroom.

Site location:

19 Lake Avenue
Rainham

Drawing No: 04

Scale: 1:100 @ A3

Date: Nov 2020




EXISTING FRONT ELEVATION



EXISTING SIDE ELEVATION



EXISTING REAR ELEVATION

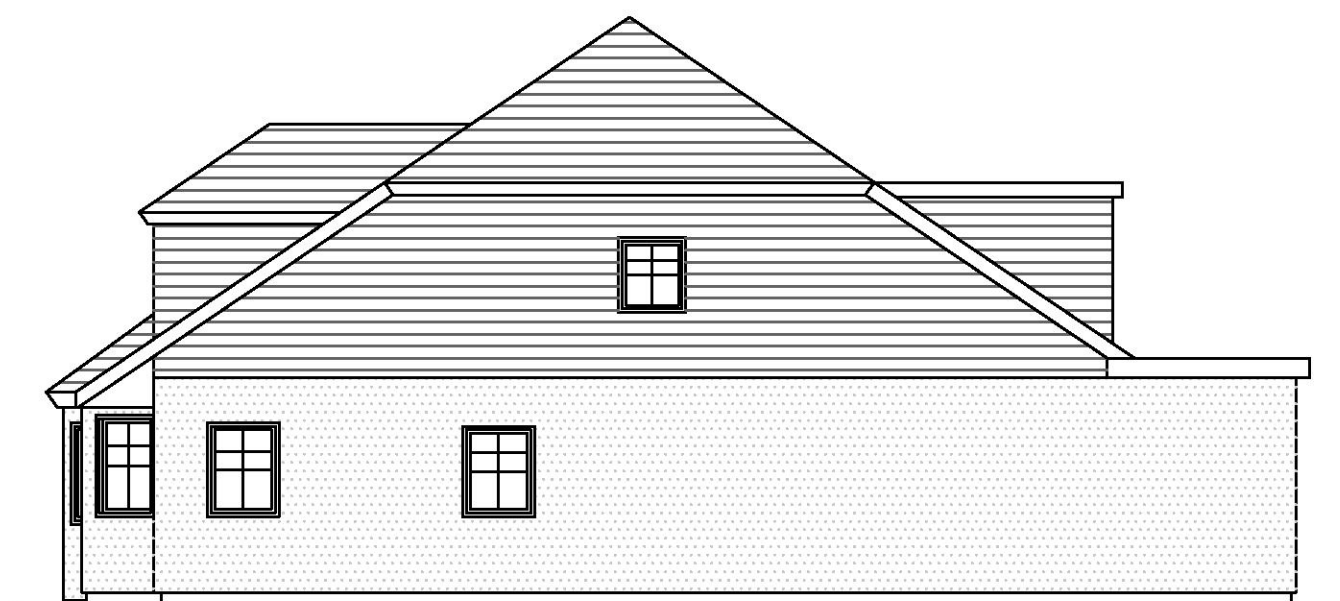

EXISTING SIDE ELEVATION

General Notes: All dimensions in mm unless specified otherwise | Contractors to confirm all dimensions on site



CITY LANDMARK DESIGNS LIMITED

City Landmark Designs
(Planning, Appeals, Architectural, Calculations, Building Construction & Management)

1 Beadles Parade, Rainham Road South, Dagenham, Essex, RM10 8YL
Tel: 0208 593 2929 Mob: 07983 965 580
Email: info@citylandmark.net
Website: www.citylandmark.net

Proposed development:

Retention of front porch hip roof, bay windows, and other external alterations. Retention of rear garden outbuilding for gym purpose including bathroom.


Site location:

19 Lake Avenue
Rainham


Drawing No: 02

Scale: 1:100 @ A3


Date: Oct 2020

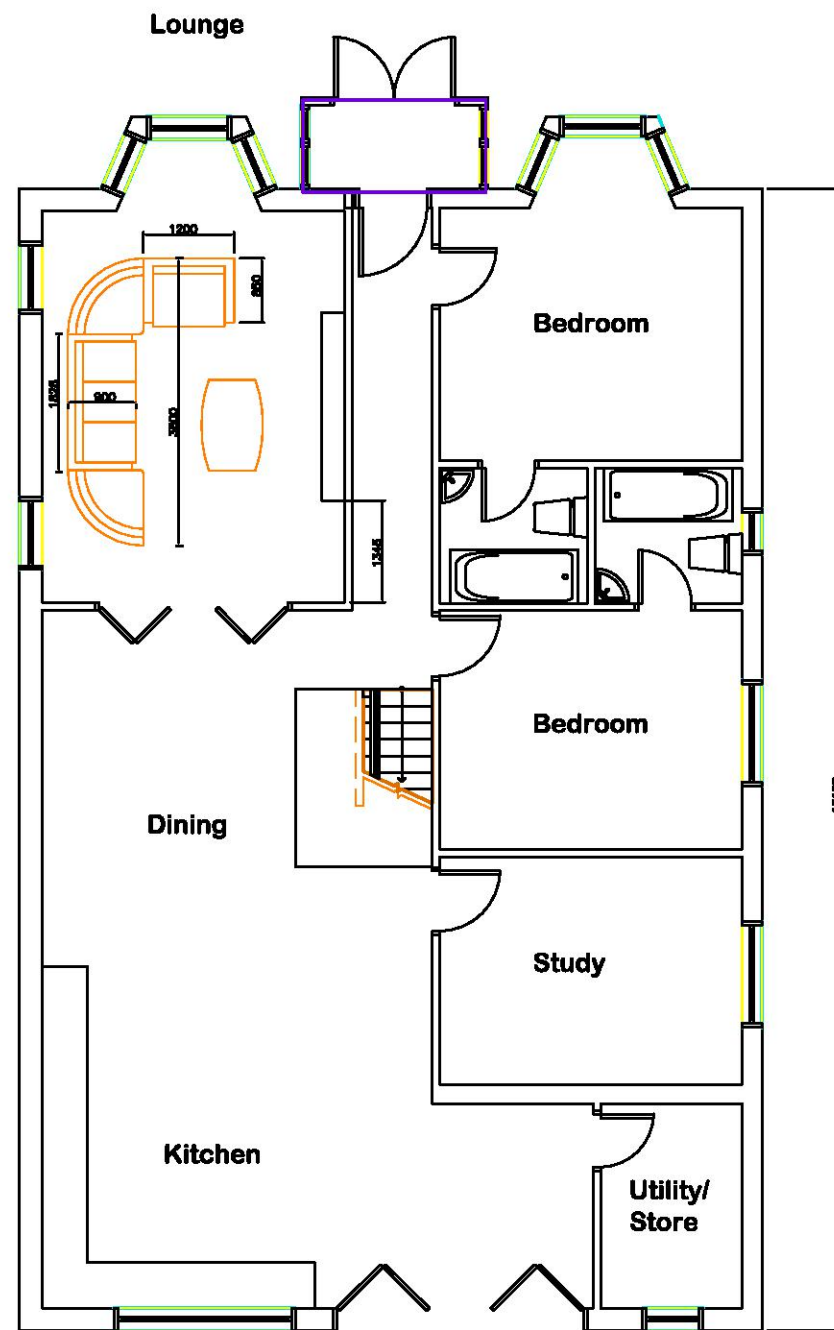

EXISTING GROUND FLOOR PLAN

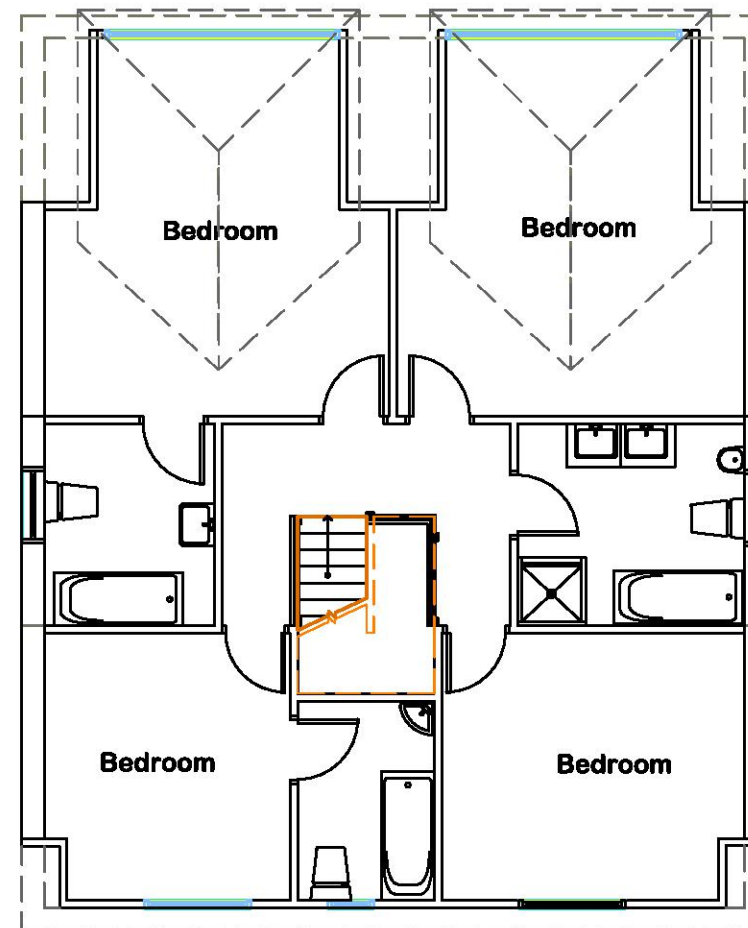

EXISTING FIRST FLOOR PLAN

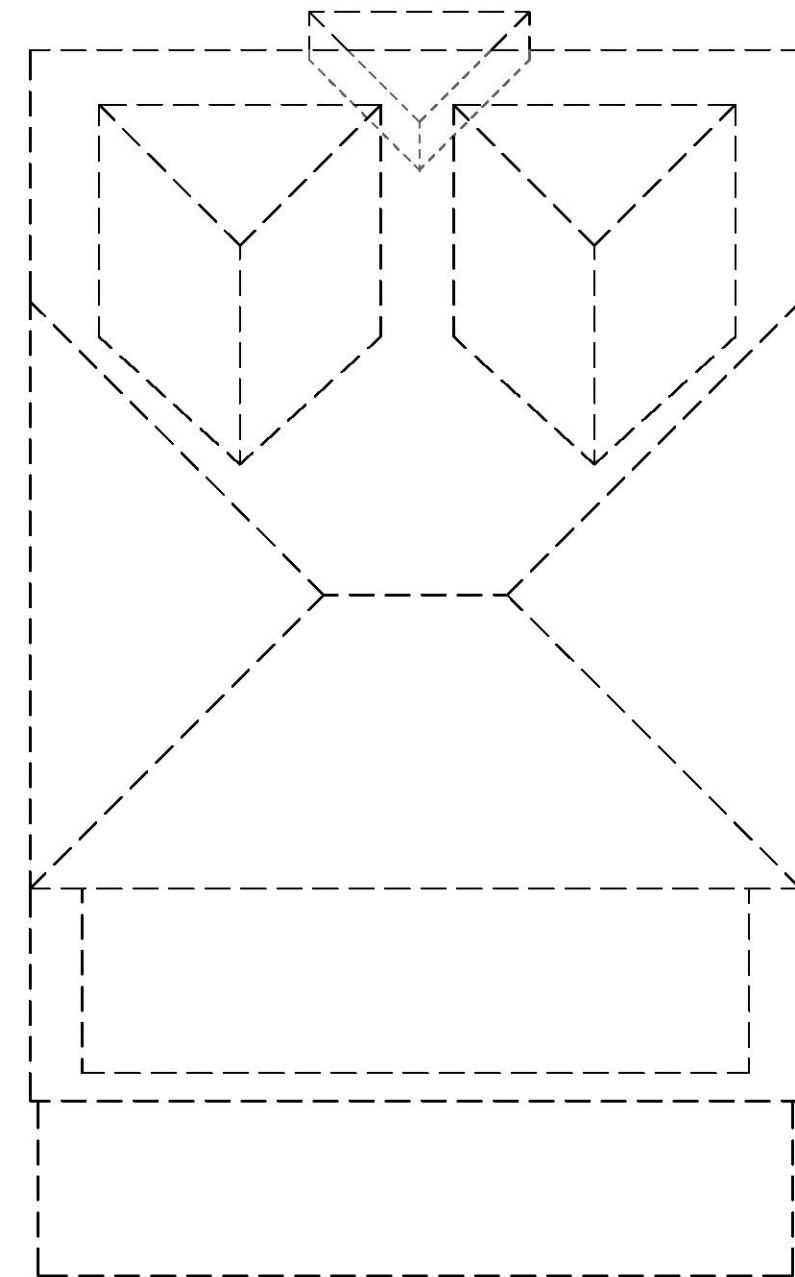

EXISTING ROOF PLAN

General Notes: All dimensions in mm unless specified otherwise | Contractors to confirm all dimensions on site



City Landmark Designs
(Planning, Appeals, Architectural, Calculations, Building Construction & Management)

1 Beadles Parade, Rainham Road South, Dagenham, Essex, RM10 8YL
Tel: 0208 593 2929 Mob: 07983 965 580
Email: info@citylandmark.net
Website: www.citylandmark.net

Proposed development:

Retention of front porch hip roof, bay windows, and other external alterations. Retention of rear garden outbuilding for gym purpose including bathroom.


Site location:

19 Lake Avenue
Rainham


Drawing No: 01

Scale: 1:100 @ A3


Date: Oct 2020

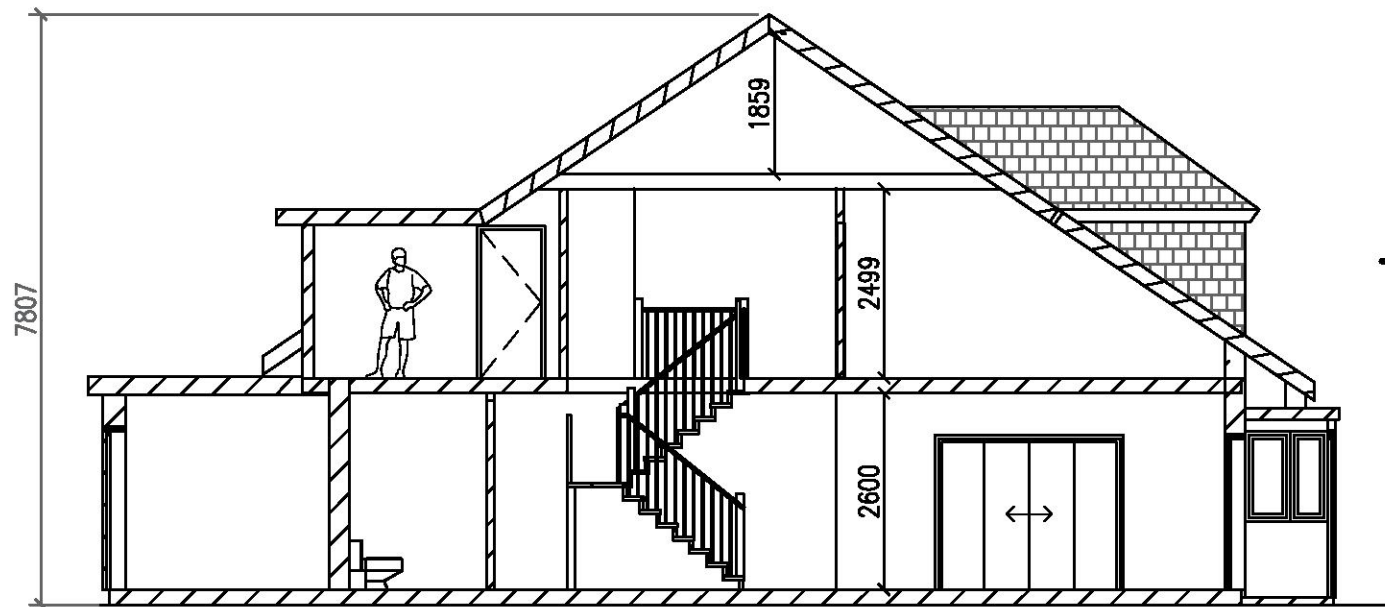

APPROVED SECTION A - A

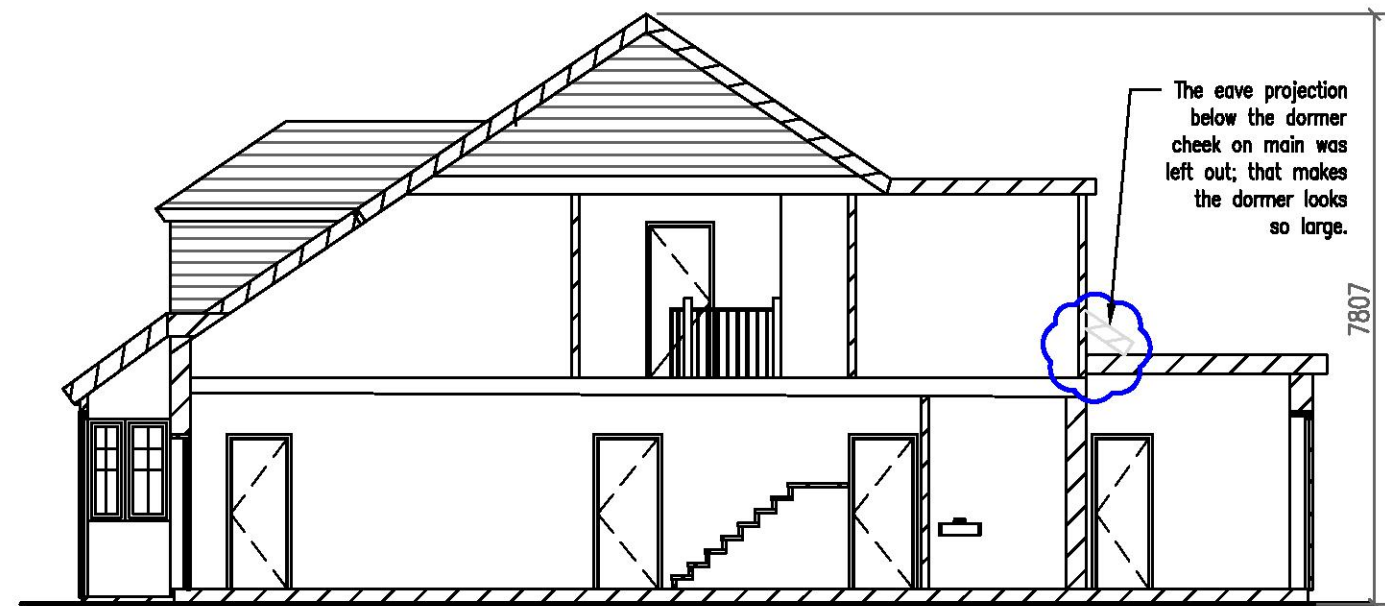

**EXISTING SECTION A - A
(AS BUILT)**

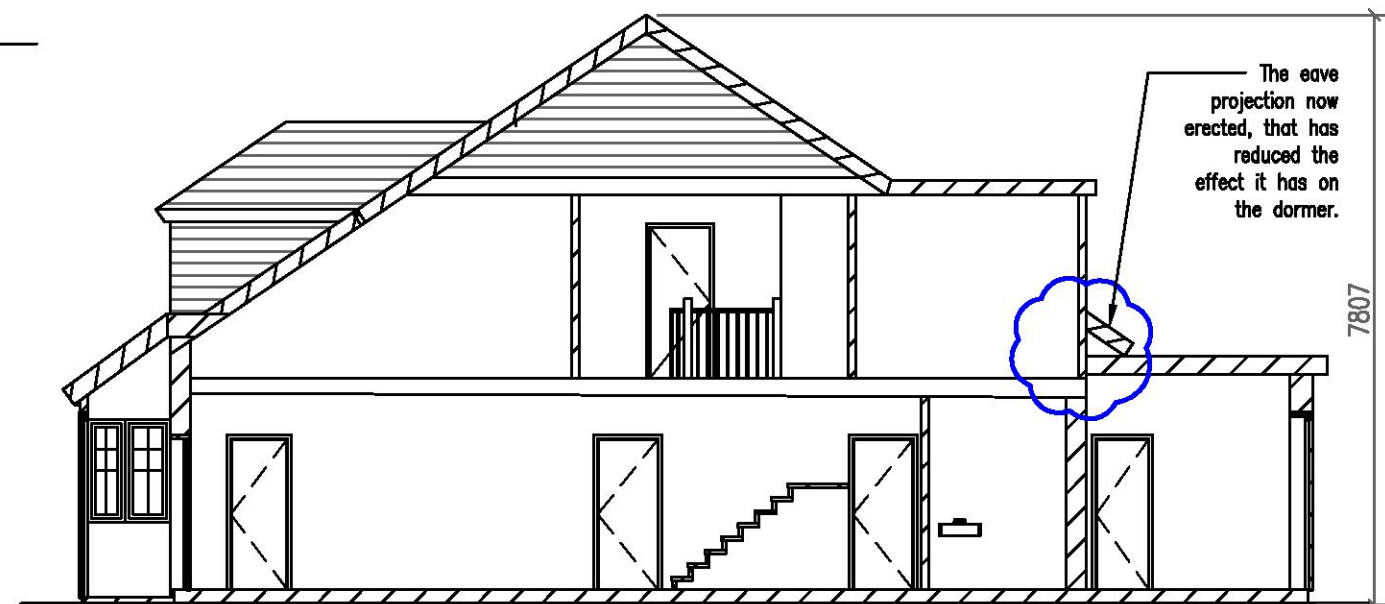

**EXISTING SECTION A - A
(AS AMENDED)**

General Notes: All dimensions in mm unless specified otherwise | Contractors to confirm all dimensions on site



CITY LANDMARK DESIGNS LIMITED

City Landmark Designs
(Planning, Appeals, Architectural, Calculations, Building Construction & Management)

1 Beadles Parade, Rainham Road South, Dagenham, Essex, RM10 8YL
Tel: 0208 593 2929 Mob: 07983 965 580
Email: info@citylandmark.net
Website: www.citylandmark.net

Proposed development:

Retention of front porch hip roof, bay windows, and other external alterations. Retention of rear garden outbuilding for gym purpose including bathroom.

Site location:

19 Lake Avenue
Rainham


Drawing No: 03

Scale: 1:100 @ A3


Date: Oct 2020




FRONT VIEW OF THE CURTILAGE OF THE DWELLING HOUSE

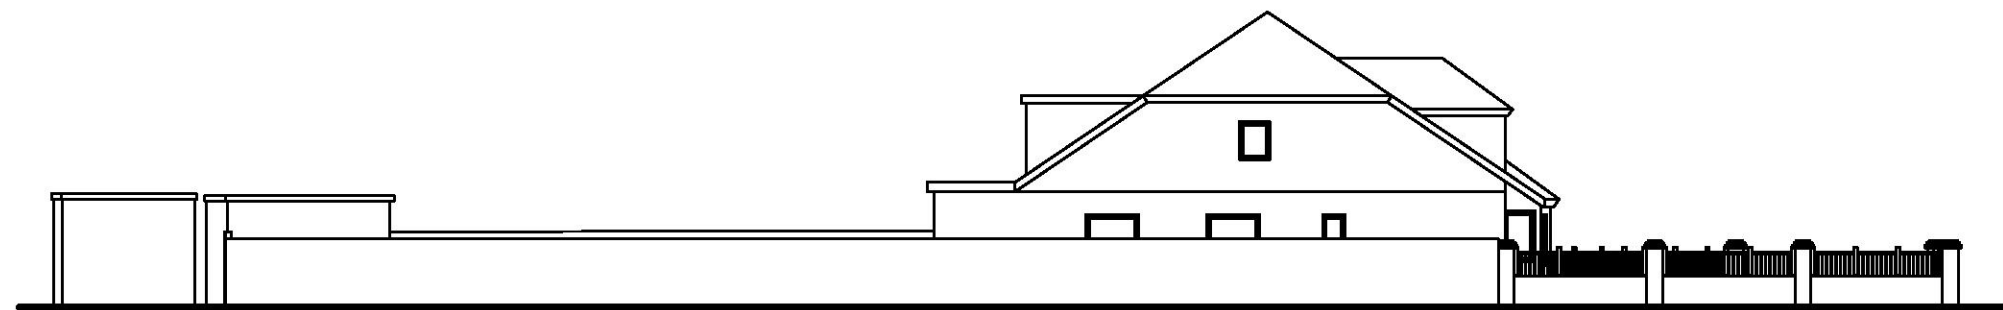



SIDE VIEW OF THE CURTILAGE OF THE DWELLING HOUSE
(VIEW FROM 17 LAKE AVENUE)

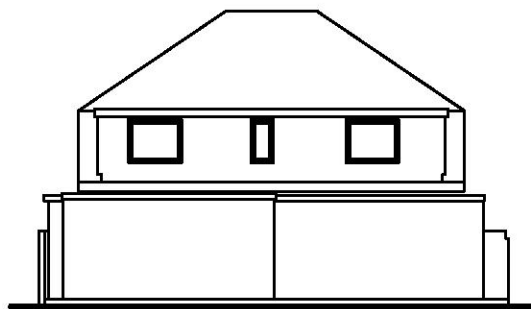

REAR VIEW OF THE CURTILAGE OF THE DWELLING HOUSE

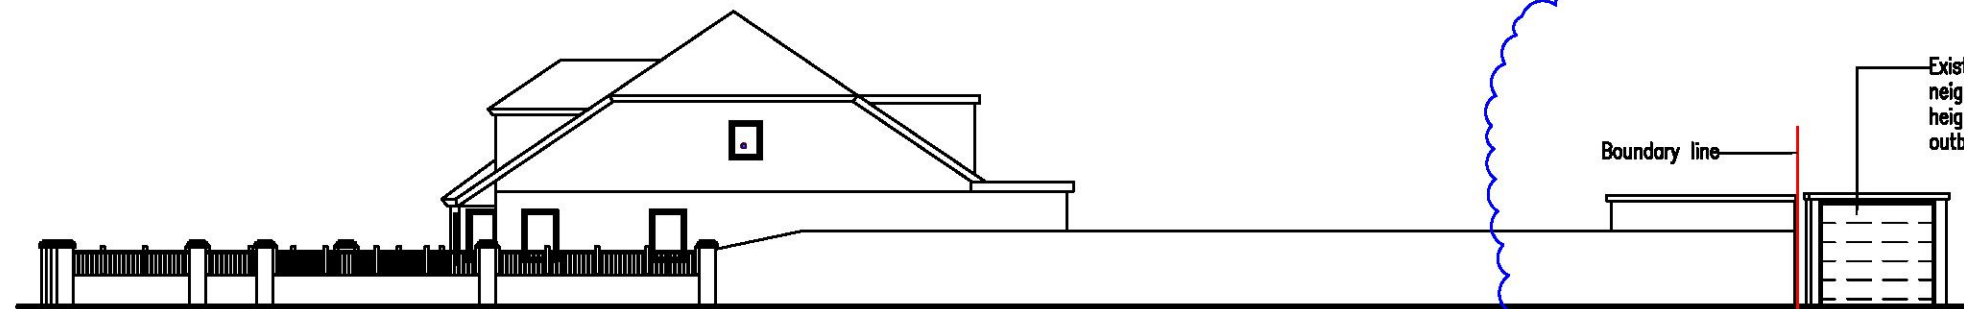

SIDE VIEW OF THE CURTILAGE OF THE DWELLING HOUSE
(VIEW FROM STOKE ROAD)

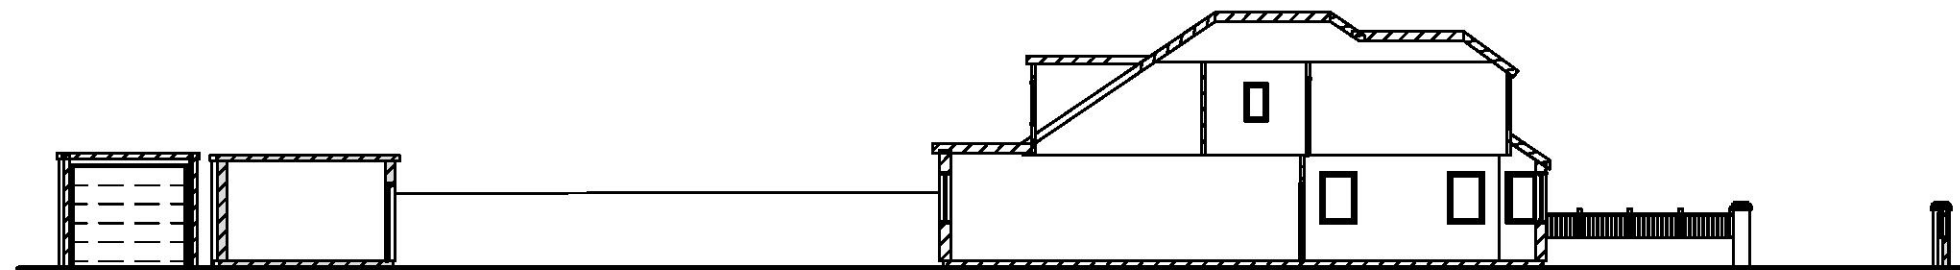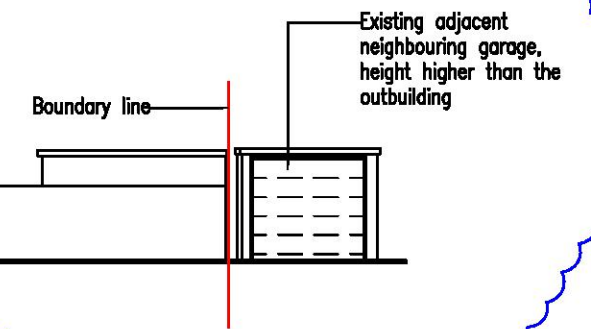

SECTION THROUGH THE CURTILAGE OF THE DWELLING HOUSE

General Notes: All dimensions in mm unless specified otherwise | Contractors to confirm all dimensions on site



City Landmark Designs
(Planning, Appeals, Architectural, Calculations, Building Construction & Management)

1 Beadles Parade, Rainham Road South, Dagenham, Essex, RM10 8YL
Tel: 0208 593 2929 Mob: 07983 965 580
Email: info@citylandmark.net
Website: www.citylandmark.net

Proposed development:

Retention of front porch hip roof, bay windows, and other external alterations. Retention of rear garden outbuilding for gym purpose including bathroom.

Site location:


19 Lake Avenue
Rainham

Drawing No: 07

Scale: 1:200 @ A3

Date: Nov 2020


OUTBUILDING

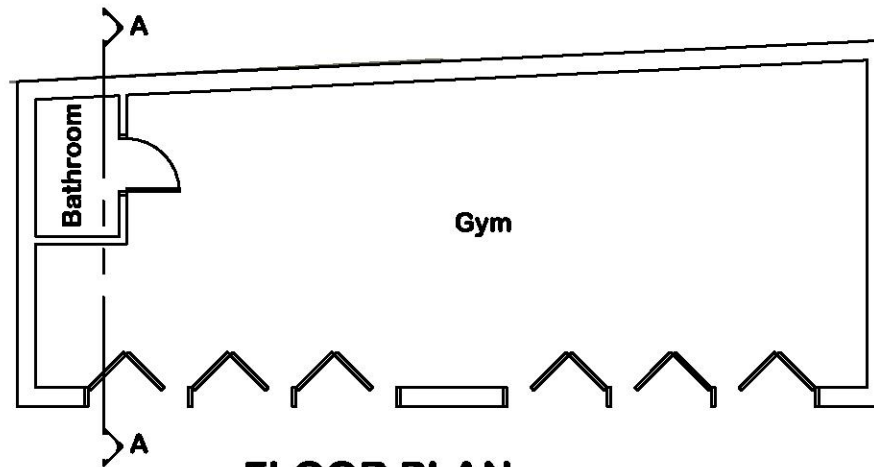


FLOOR PLAN



ROOF PLAN

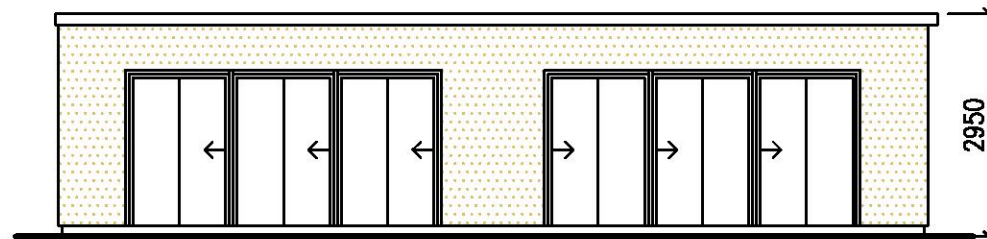


PROPOSED FRONT ELEVATION

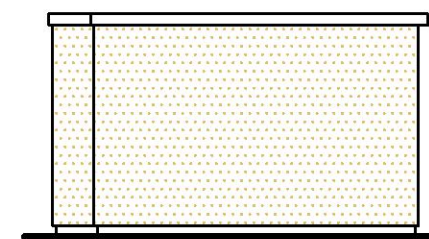


PROPOSED SIDE ELEVATION


OUTBUILDING

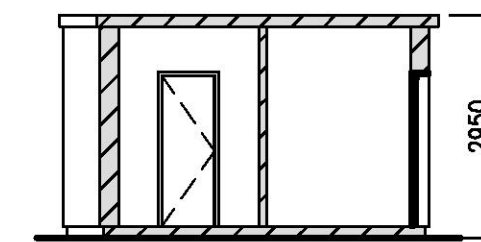

PROPOSED SECTION A - A

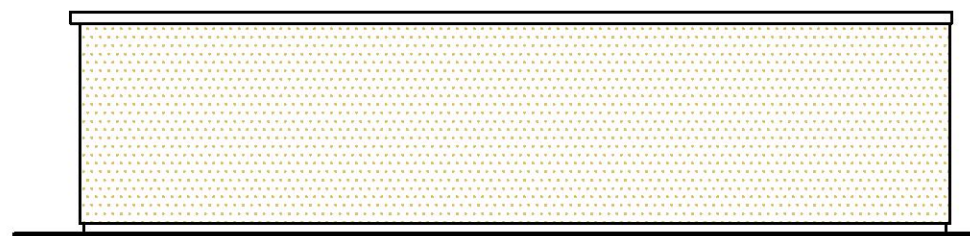

PROPOSED REAR ELEVATION

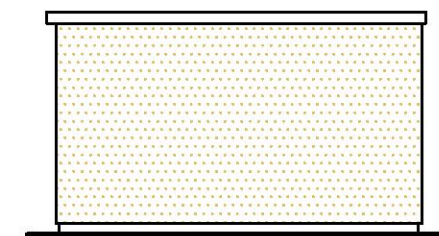

PROPOSED SIDE ELEVATION

General Notes: All dimensions in mm unless specified otherwise | Contractors to confirm all dimensions on site



CITY LANDMARK DESIGNS LIMITED

City Landmark Designs
(Planning, Appeals, Architectural, Calculations, Building Construction & Management)

1 Beadles Parade, Rainham Road South, Dagenham, Essex, RM10 8YL
Tel: 0208 593 2929 Mob: 07983 965 580
Email: info@citylandmark.net
Website: www.citylandmark.net

Proposed development:

Retention of front porch hip roof, bay windows, and other external alterations. Retention of rear garden outbuilding for gym purpose including bathroom.


Site location:

19 Lake Avenue
Rainham

Drawing No: 06

Scale: 1:100 @ A3

Date: Nov 2020

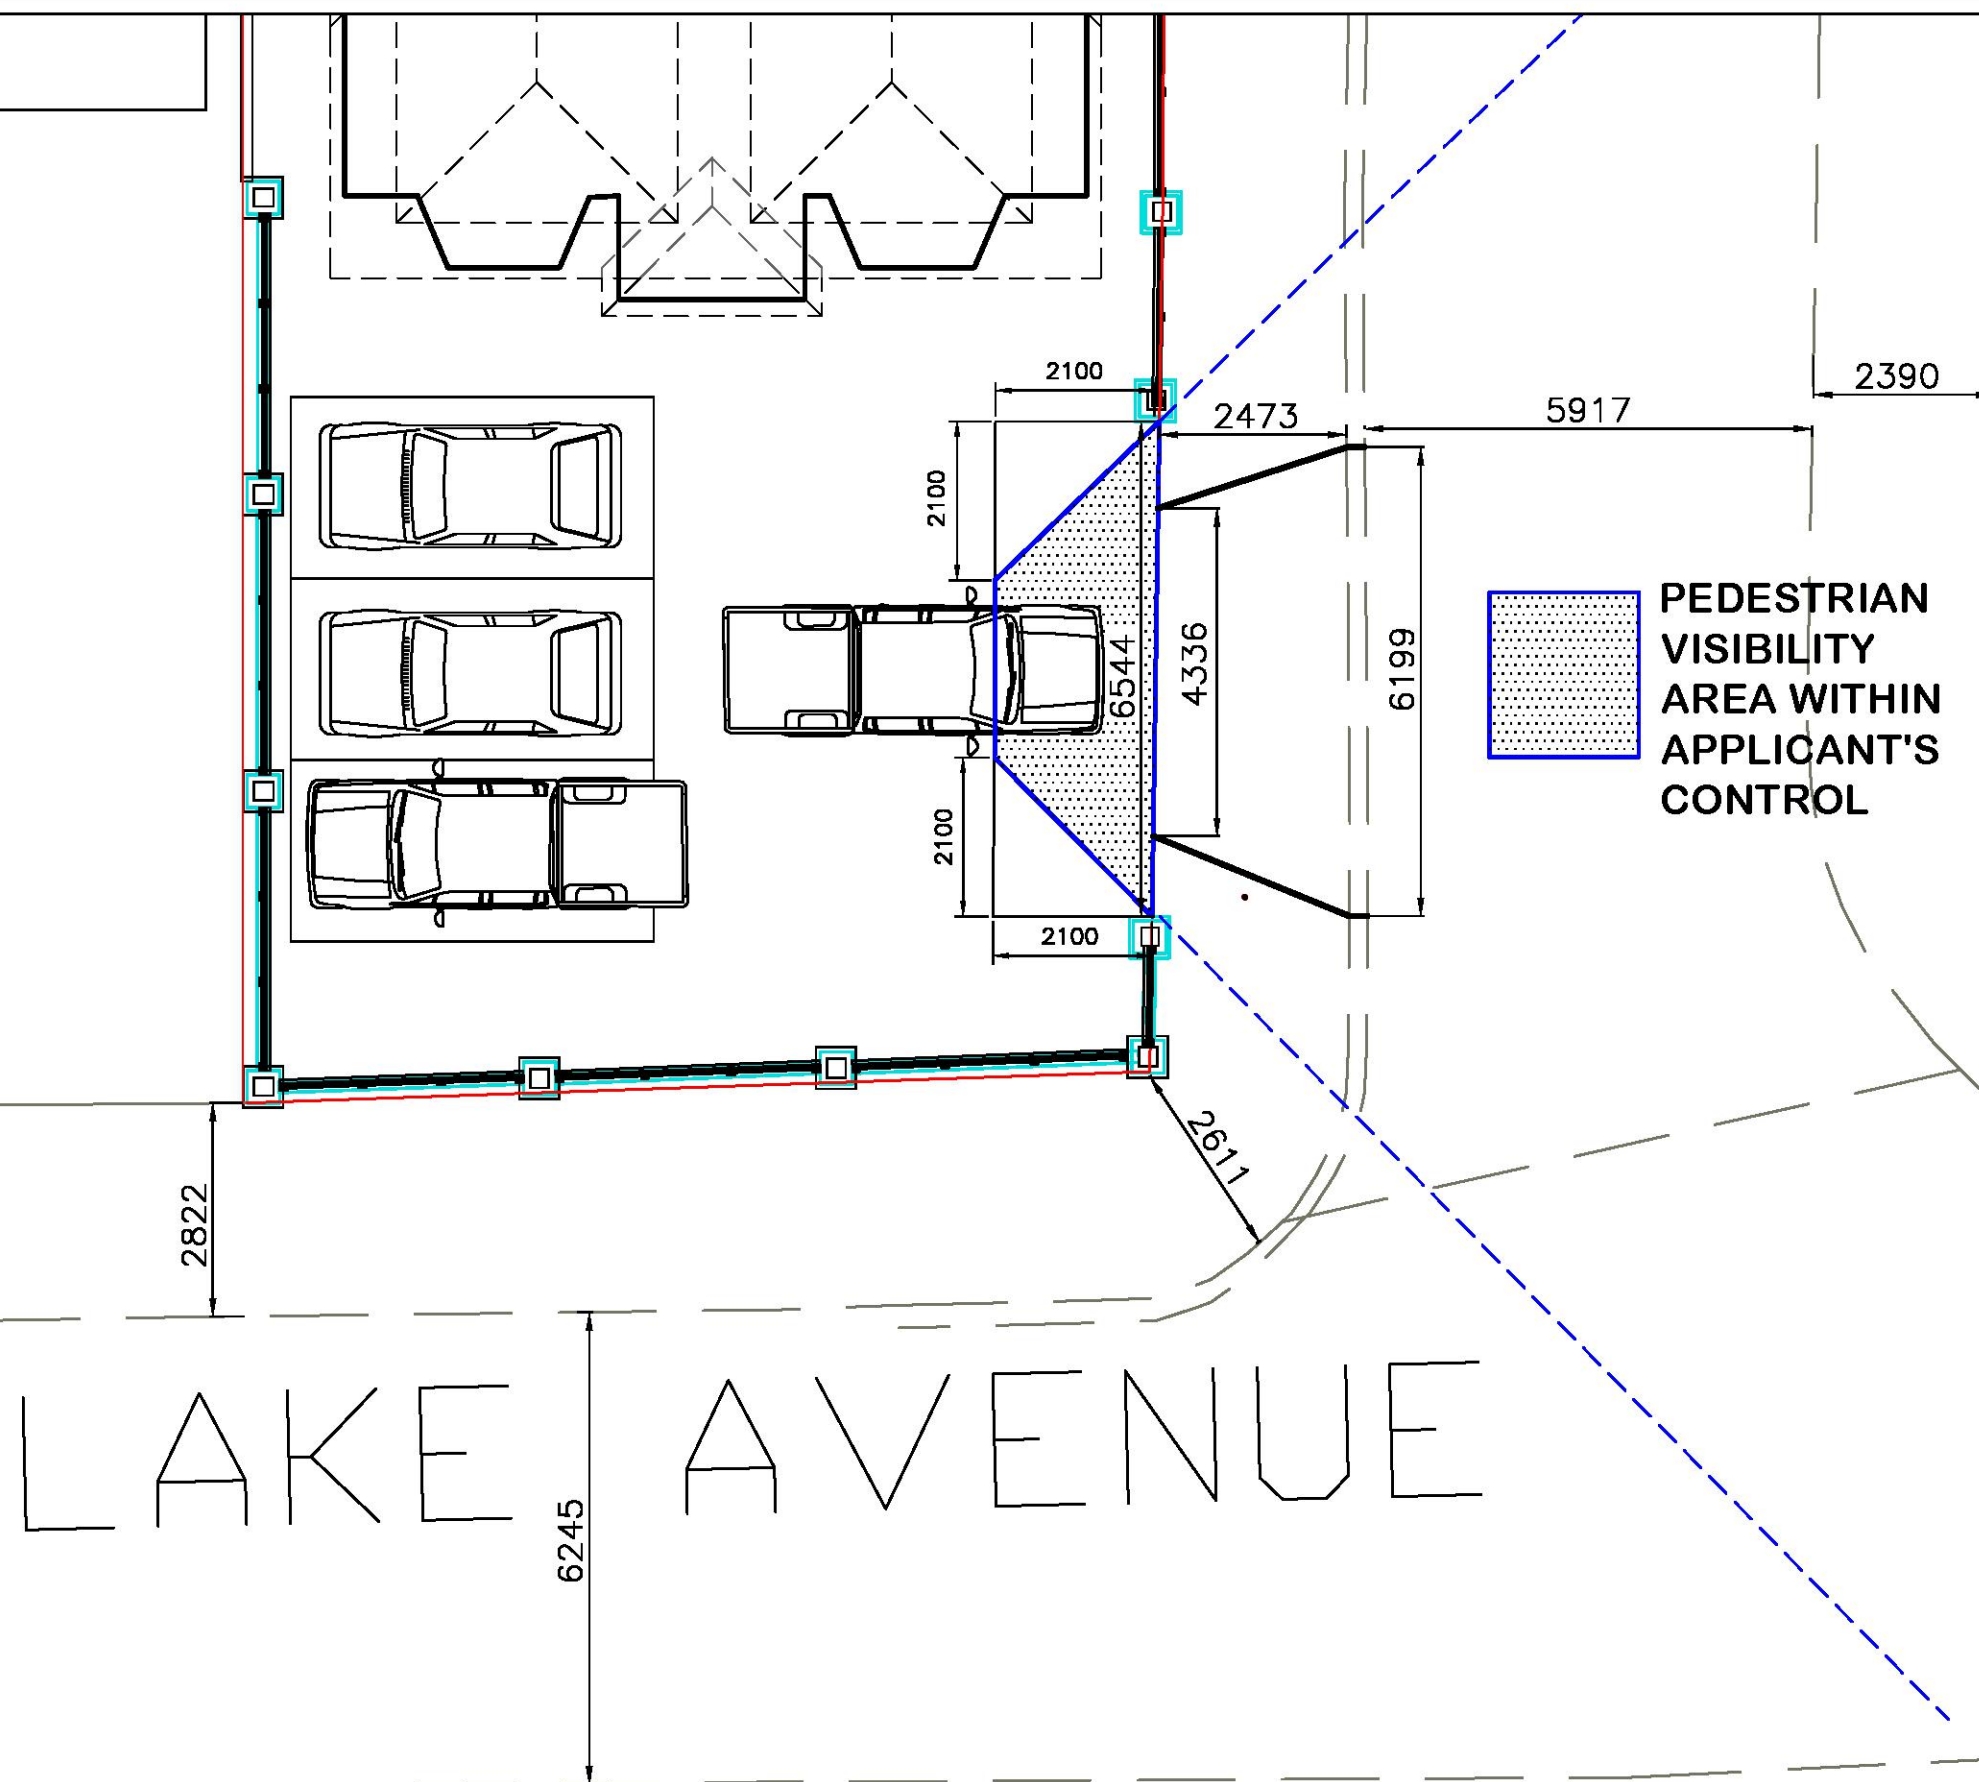

General Notes: All dimensions in mm unless specified otherwise | Contractors to confirm all dimensions on site



City Landmark Designs
(Planning, Appeals, Architectural, Calculations, Building Construction & Management)

1 Beadles Parade, Rainham Road South, Dagenham, Essex, RM10 8YL
Tel: 0208 593 2929 Mob: 07983 965 580
Email: info@citylandmark.net
Website: www.citylandmark.net

Proposed development:

Retention of front porch hip roof, bay windows, and other external alterations. Retention of rear garden outbuilding for gym purpose including bathroom, and boundary fence and crossover


Site location:

19 Lake Avenue
Rainham


Drawing No: 09c

Scale: 1:100@ A3


Date: Dec 2020

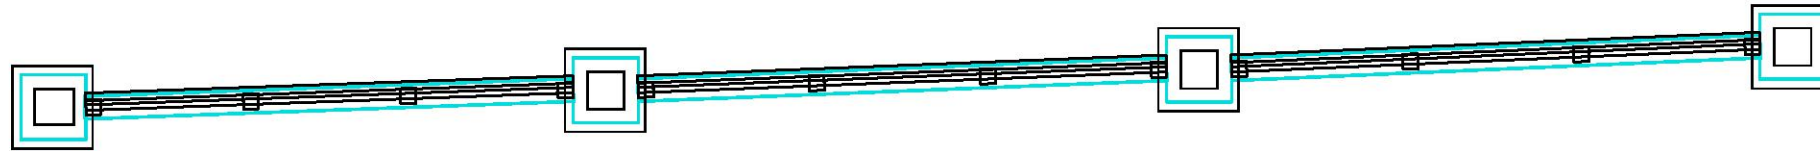

EXISTING FRONT PLAN

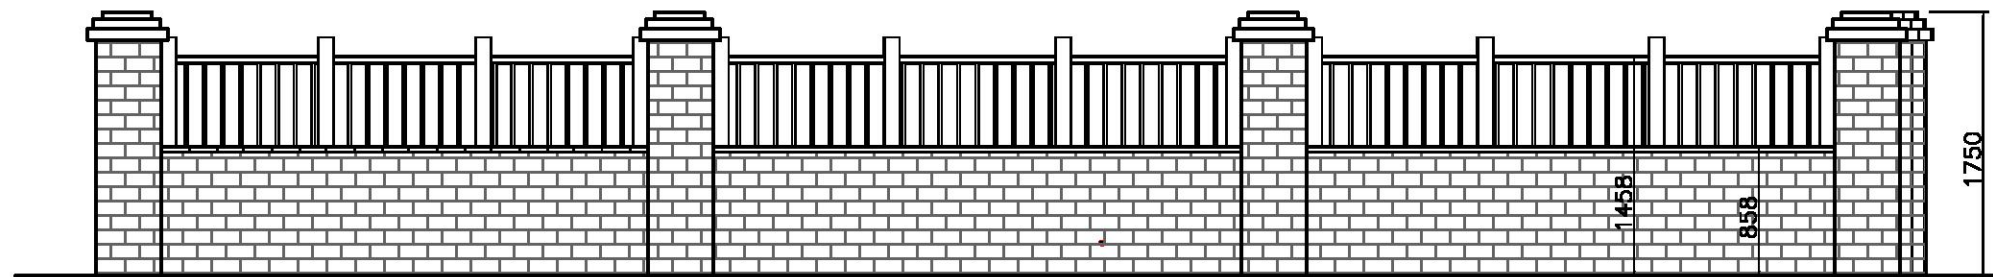

EXISTING SIDE ELEVATION

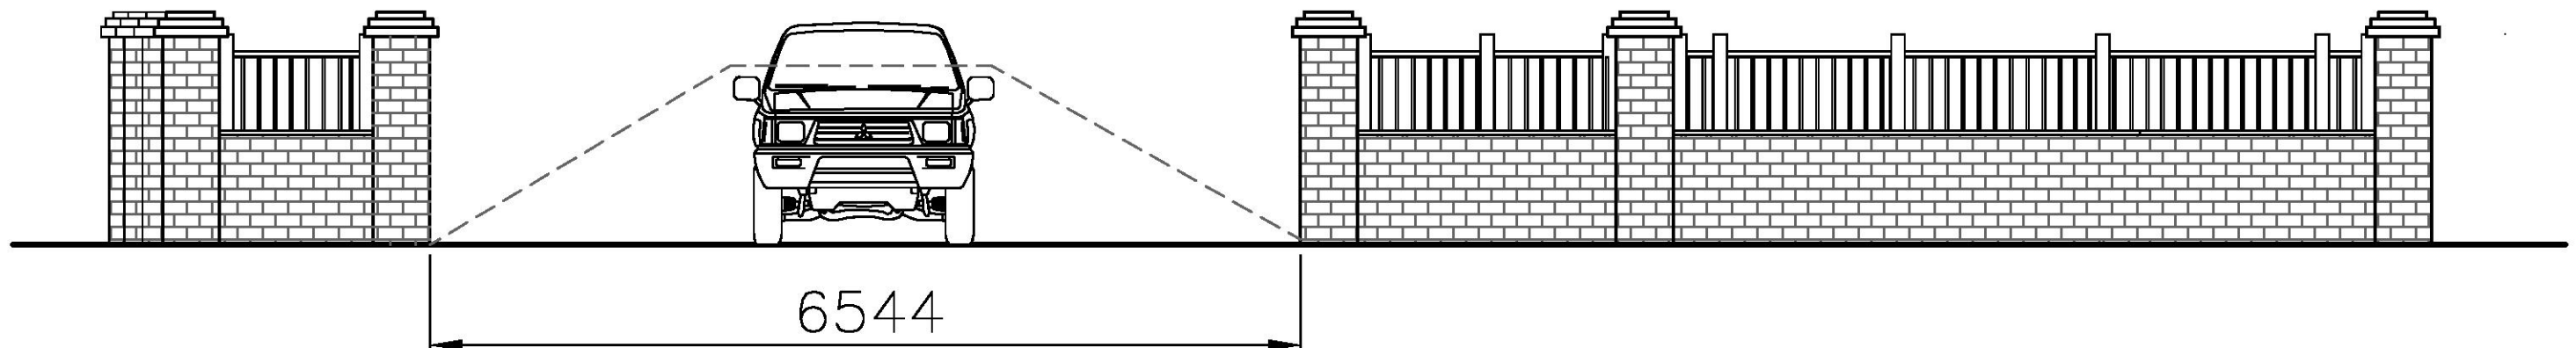

EXISTING SIDE ELEVATION

General Notes: All dimensions in mm unless specified otherwise | Contractors to confirm all dimensions on site



City Landmark Designs
(Planning, Appeals, Architectural, Calculations, Building Construction & Management)

1 Beadles Parade, Rainham Road South, Dagenham, Essex, RM10 8YL
Tel: 0208 593 2929 Mob: 07983 965 580
Email: info@citylandmark.net
Website: www.citylandmark.net

Proposed development:

Retention of front porch hip roof, bay windows, and other external alterations. Retention of rear garden outbuilding for gym purpose including bathroom, and boundary fence and crossover

Site location:

19 Lake Avenue
Rainham

Drawing No: o8b

Scale: 1:50 @ A3

Date: Dec 2020