
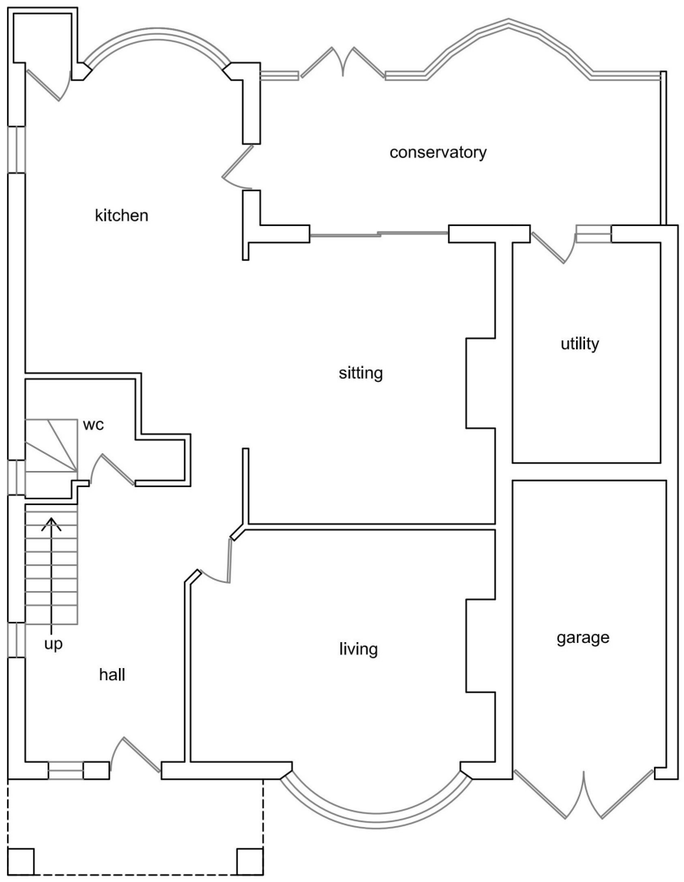


Ground Floor Plan

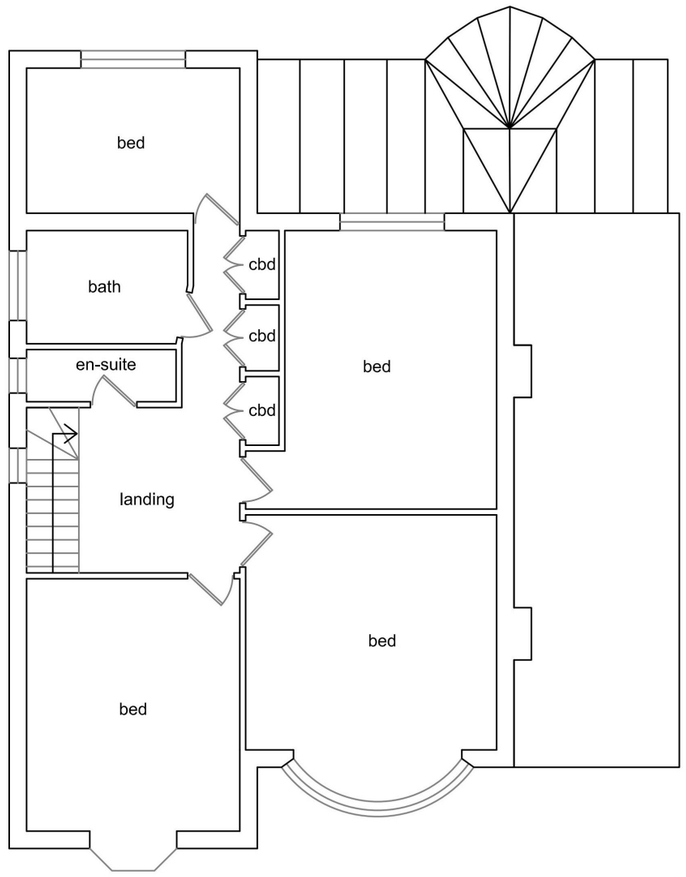

First Floor Plan

Patrick Stroud Designs Ltd,
43 Albermarle Link,
Chelmsford,
Essex
CM1 6AH
M 07955 687623
E: patrickjstroud@btinternet.com

Client : Mr R. Ross

Project : 27 Wallenger Avenue, Gidea Park

Drawing : Existing / Original Plans

Scale : 1:100 @ A3

0 1 2 3 4 5

Status : PLANNING

Rev : .

Dwg No : 2026.985.02

© THIS DRAWING IS THE COPYRIGHT OF PATRICK STROUD DESIGNS LTD.
It shall not be in any way used or reproduced without their prior written consent. All dimensions are to be checked on site or in the workshop prior to commencing any work. Work only to figured dimensions. Any discrepancies are to be reported to the Architect.

C:\Users\Pat\OneDrive\Documents\New Projects\2026.985 - 27 Wallenger\985RRW



Front Elevation



Side Elevation

red plantiles
white eaves & black rainwater goods
white upvc windows
white render
black timber boarding
white upvc windows & black doors
red brick



Rear Elevation



Side Elevation

red plantiles
white eaves & black rainwater goods
white upvc windows
black timber boarding
white render
white upvc windows & doors
red brick

Patrick Stroud Designs Ltd,
43 Albermarle Link,
Chelmsford,
Essex
CM1 6AH
M 07955 687623
E: patrickjstroud@btinternet.com

Client : Mr R. Ross

Project : 27 Wallenger Avenue, Gidea Park

Drawing : Existing / Original Elevations

Scale : 1:100 @ A3

0 1 2 3 4 5


Status : PLANNING

Rev : .


Dwg No : 2026.985.03

© THIS DRAWING IS THE COPYRIGHT OF PATRICK STROUD DESIGNS LTD.
It shall not be in any way used or reproduced without their prior written consent. All dimensions are to be checked on site or in the workshop prior to commencing any work. Work only to figured dimensions. Any discrepancies are to be reported to the Architect.

C:\Users\Pat\OneDrive\Documents\New Projects\2026.985 - 27 Wallenger\985RRW

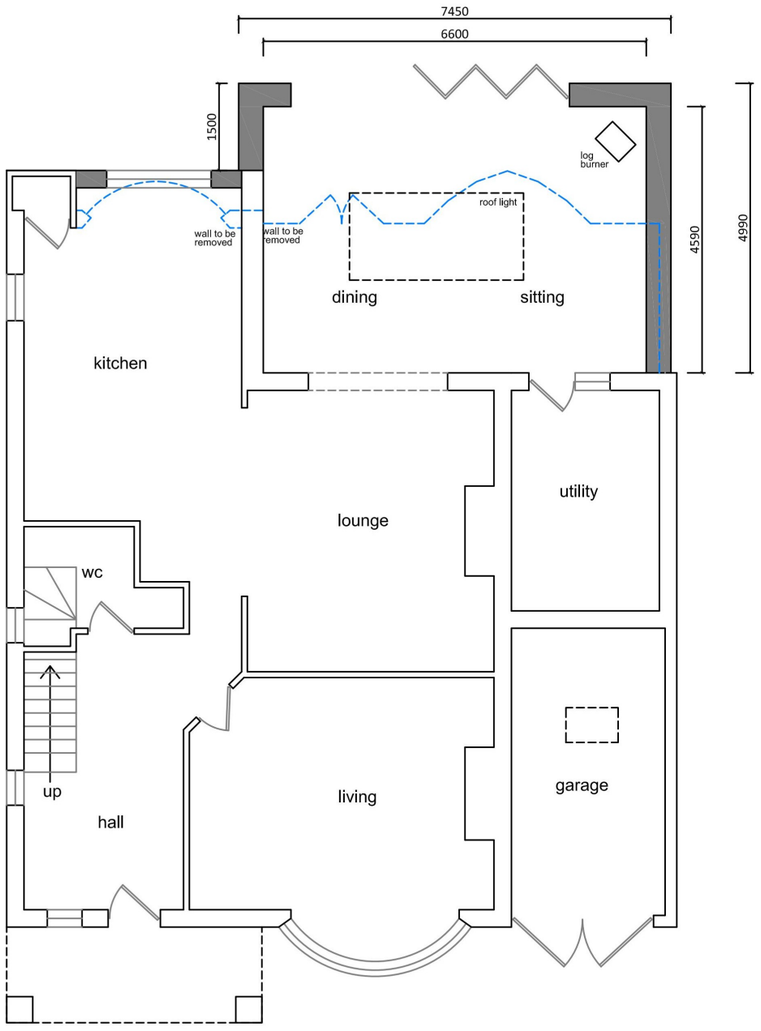

Ground Floor Plan

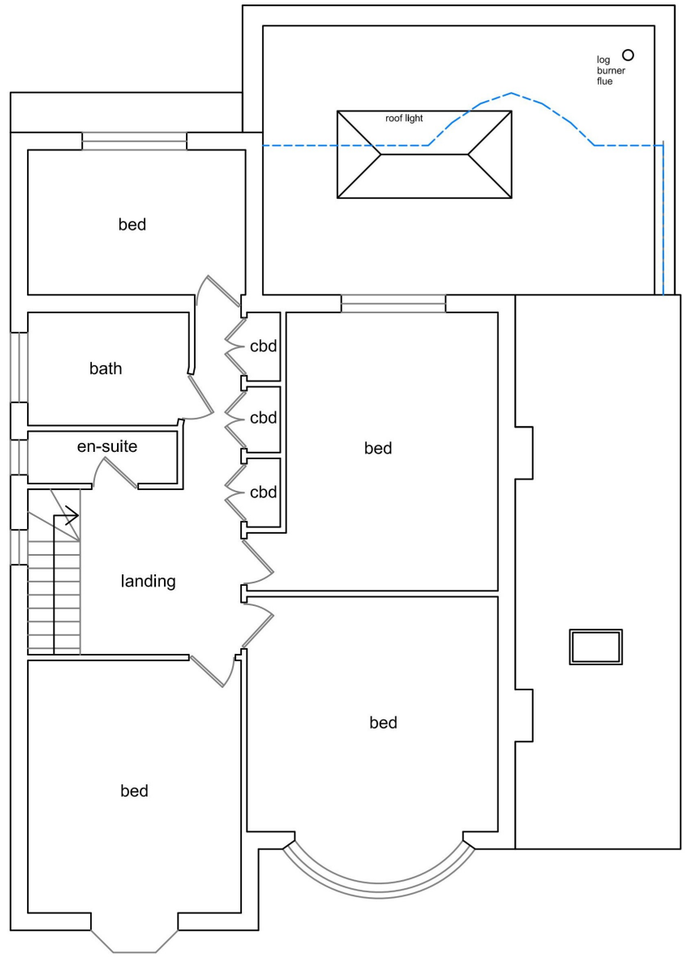

First Floor Plan

Patrick Stroud Designs Ltd,
43 Albermarle Link,
Chelmsford,
Essex
CM1 6AH
M 07955 687623
E: patrickjstroud@btinternet.com

Client : Mr R. Ross

Project : 27 Wallenger Avenue, Gidea Park

Drawing : Proposed / As Built Plans

Scale : 1:100 @ A3

0 1 2 3 4 5

Status : PLANNING

Rev : .

Dwg No : 2026.985.04

© THIS DRAWING IS THE COPYRIGHT OF PATRICK STROUD DESIGNS LTD.
It shall not be in any way used or reproduced without their prior written consent. All dimensions are to be checked on site or in the workshop prior to commencing any work. Work only to figured dimensions. Any discrepancies are to be reported to the Architect.


C:\Users\Pat\OneDrive\Documents\New Projects\2026.985 - 27 Wallenger\985RRW



Front Elevation



Side Elevation

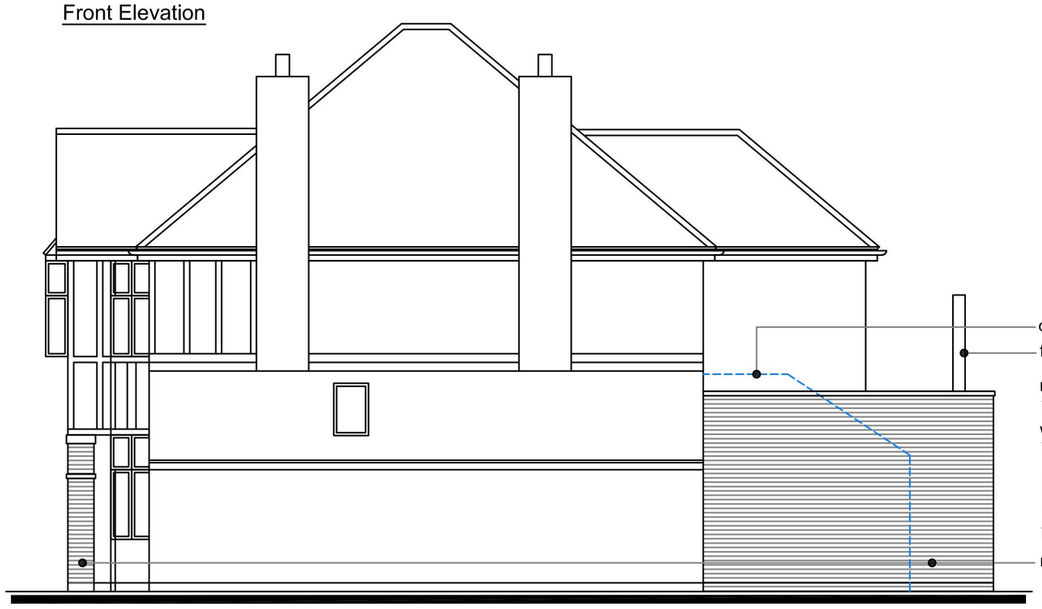

Side Elevation



Rear Elevation

Patrick Stroud Designs Ltd,
43 Albermarle Link,
Chelmsford,
Essex
CM1 6AH
M 07955 687623
E: patrickjstroud@btinternet.com

Client : Mr R. Ross

Project : 27 Wallenger Avenue, Gidea Park

Scale : 1:100 @ A3

0 1 2 3 4 5

Status : PLANNING


Rev : .

Drawing : Proposed / As Built Elevations

Dwg No : 2026.985.05

© THIS DRAWING IS THE COPYRIGHT OF PATRICK STROUD DESIGNS LTD.
It shall not be in any way used or reproduced without their prior written consent. All dimensions are to be checked on site or in the workshop prior to commencing any work. Work only to figured dimensions. Any discrepancies are to be reported to the Architect.


C:\Users\Pat\OneDrive\Documents\New Projects\2026.985 - 27 Wallenger\985RRW

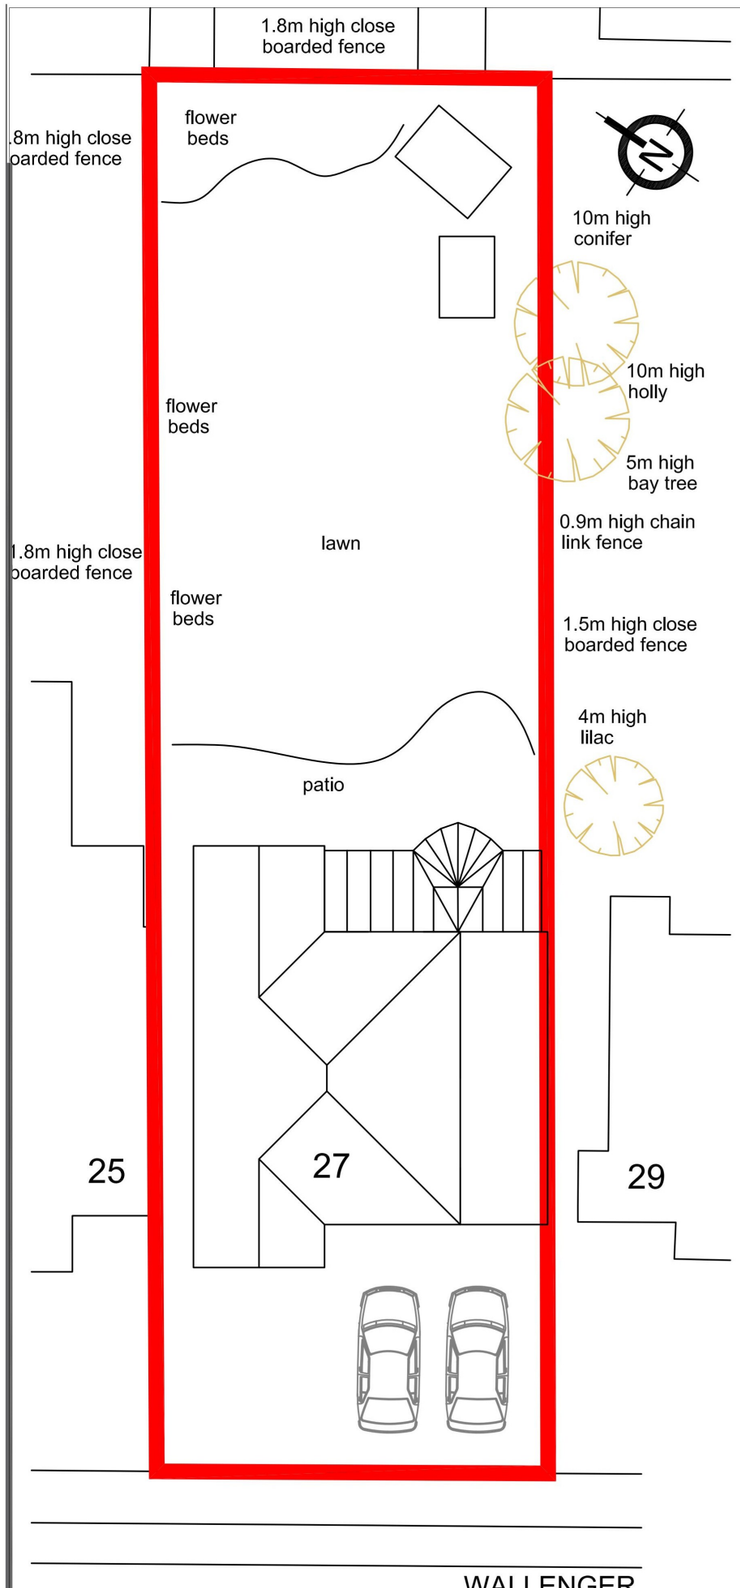

Existing / Original Site Plan

0 2 4 6 8 10

METRES 1:200

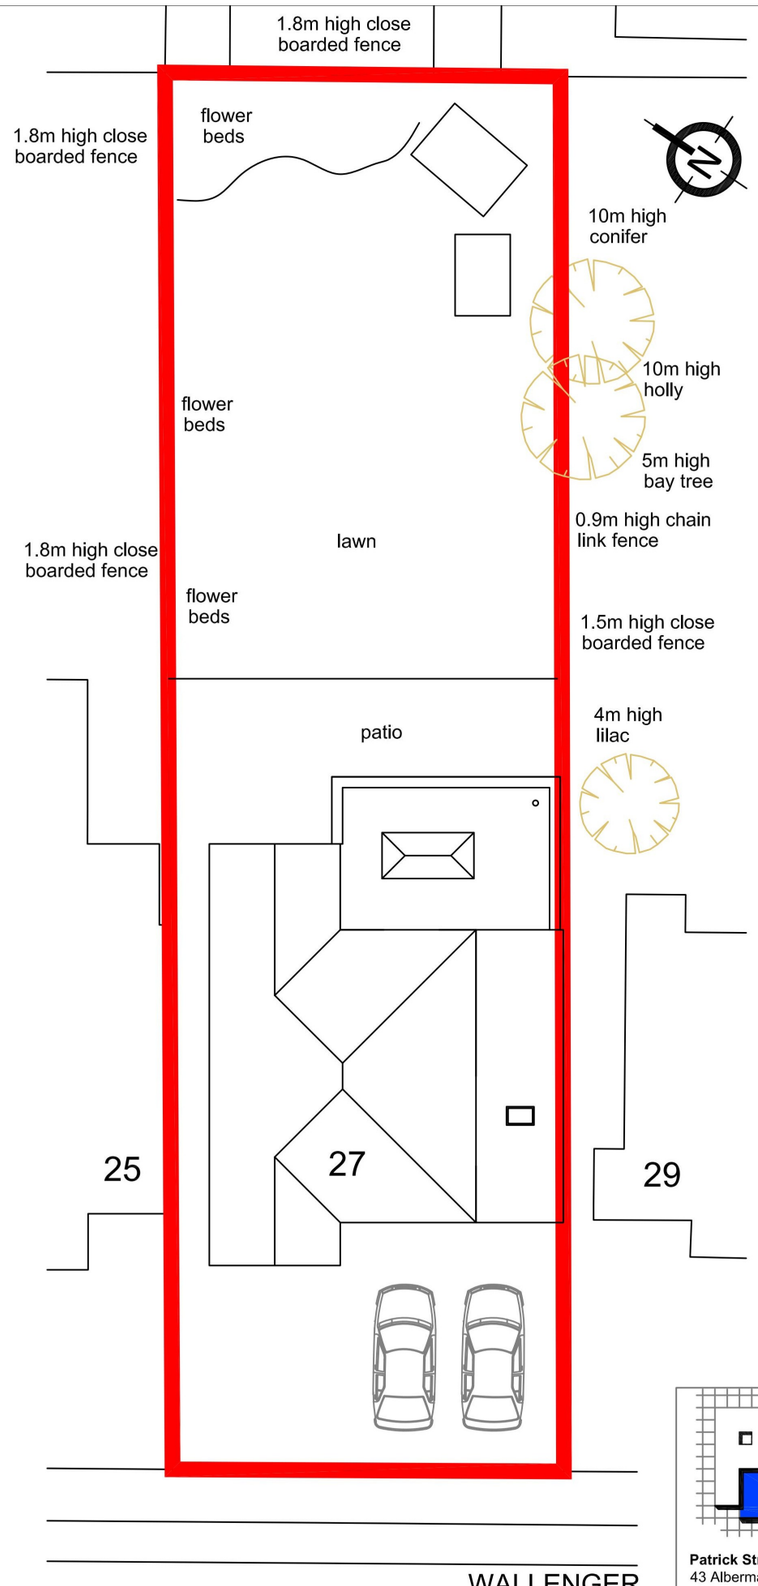

Proposed / as built Site Plan

0 2 4 6 8 10

METRES 1:200



Location Plan 1:1250

Patrick Stroud Designs Ltd,
43 Albermarle Link,
Chelmsford,
Essex
CM1 6AH
M 07955 687623
E: patrickjstroud@btinternet.com

Client : Mr R. Ross	Scale : 1:1250 @ A3 (0 25 50)
Project : 27 Wallenger Avenue, Gidea Park	Status : PLANNING
	Rev : .
Drawing : Location Plan	Dwg No : 2026.985.01

© THIS DRAWING IS THE COPYRIGHT OF PATRICK STROUD DESIGNS LTD.
It shall not be in any way used or reproduced without their prior written consent. All dimensions are to be checked on site or in the workshop prior to commencing any work. Work only to figured dimensions. Any discrepancies are to be reported to the Architect.

C:\Users\Pat\OneDrive\Documents\New Projects\2026.985 - 27 Wallenger\985RRW