
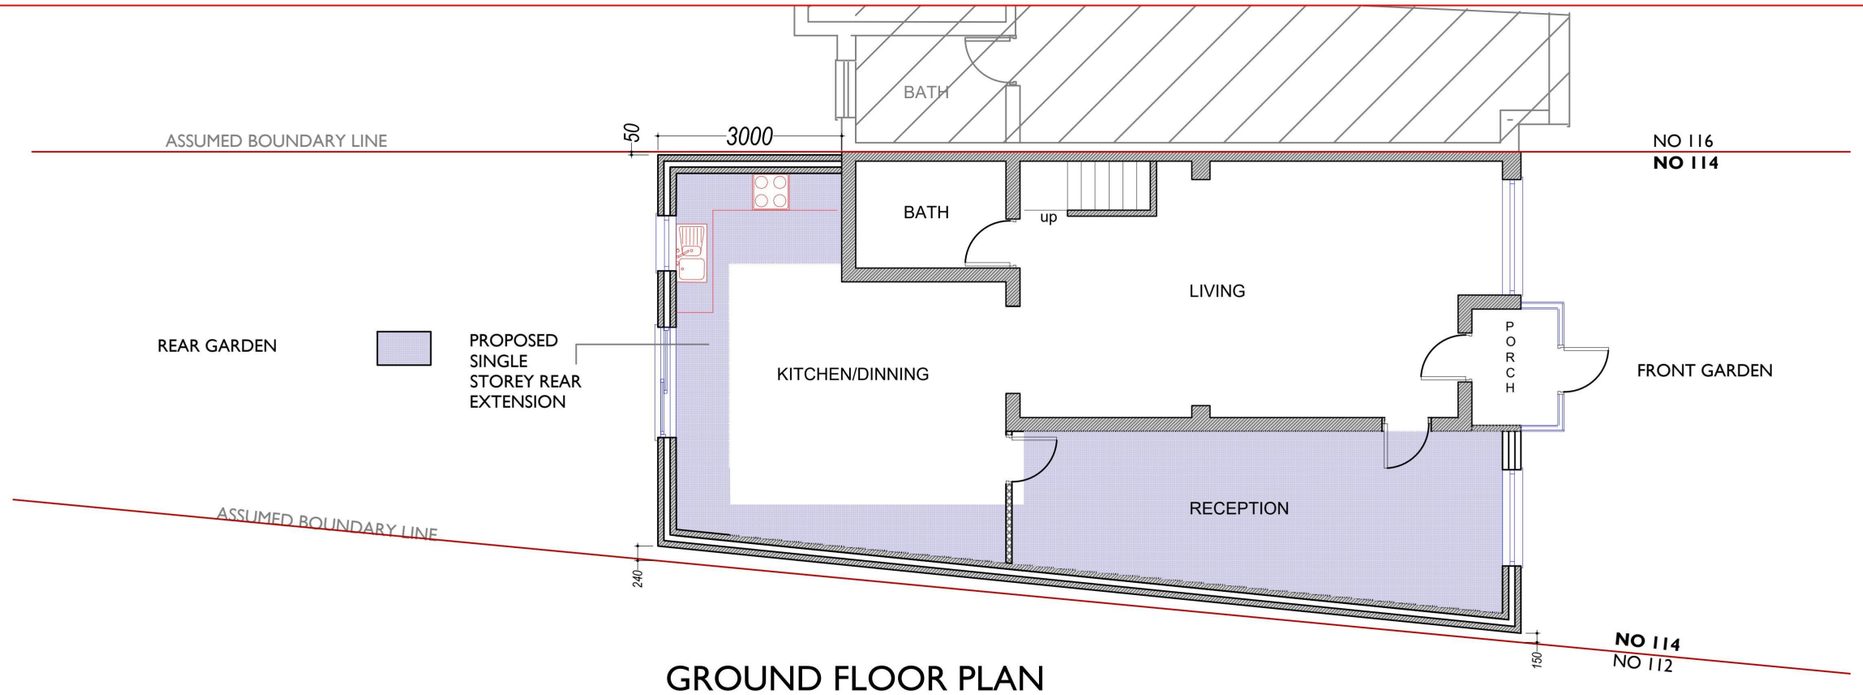


GROUND FLOOR PLAN
AS APPROVED REF NO P0047.23

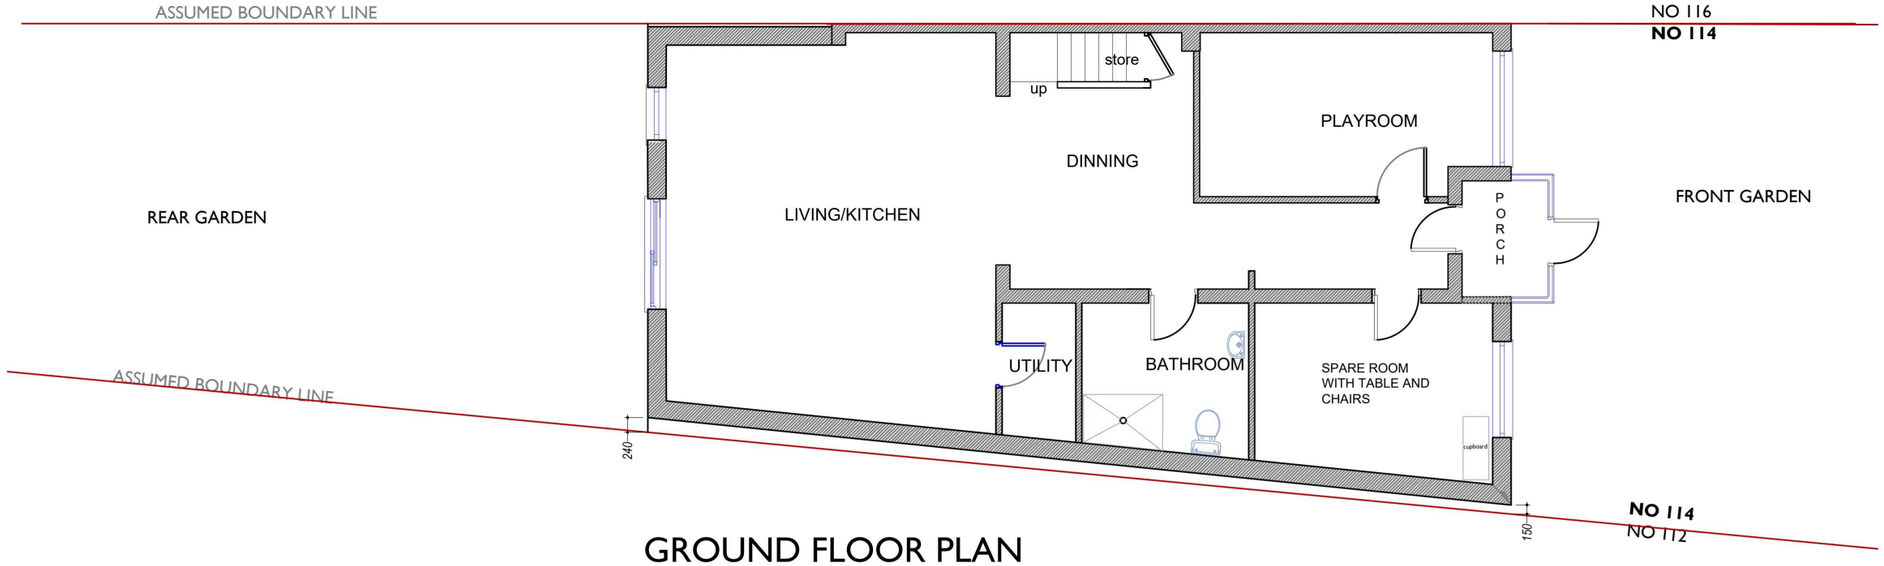

GROUND FLOOR PLAN
AS BUILT

0 1 2 3 4 5

Meters @ 1:100 @ A3

SCALE: 1:100


DATE: EFB 25

DRG NO: A 0102/01 Revision B


ISSUE:VARIATION OF CONDITION

DESCRIPTION:Variation of conditions no. 2 (Materials) and 3 (Approved Plans) of planning permission Ref: P0047.23 dated 15/03/2023 to regularise amendments to materials and internal and external layout (Retrospective) (Part single, part two storey front/side extension, part single, part two storey rear extension) at 114 Diban Avenue Hornchurch RM12 4YH

A R T T Z.ltd
Architectural Consultants

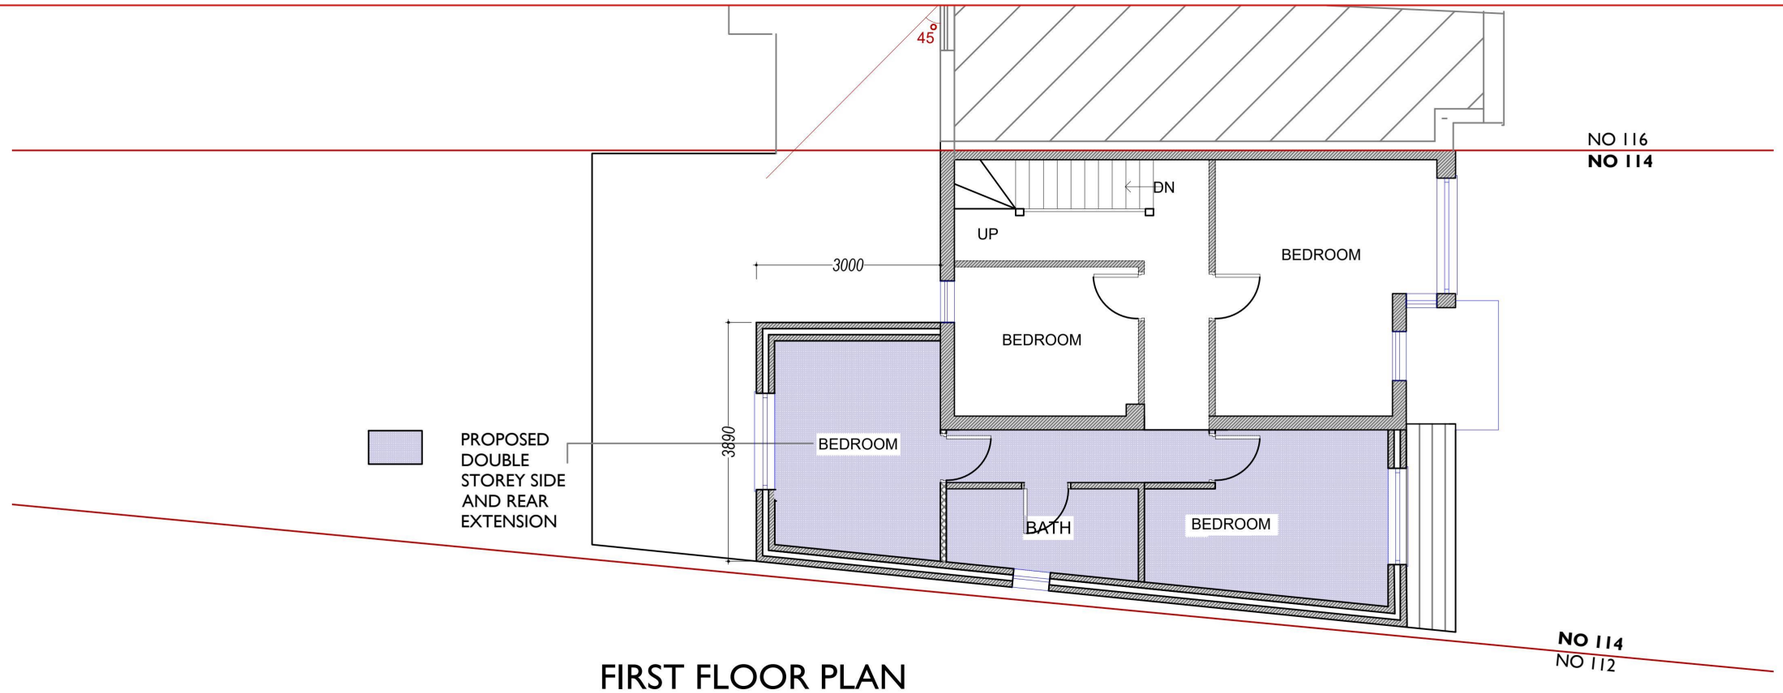

FIRST FLOOR PLAN
AS APPROVED REF NO P0047.23

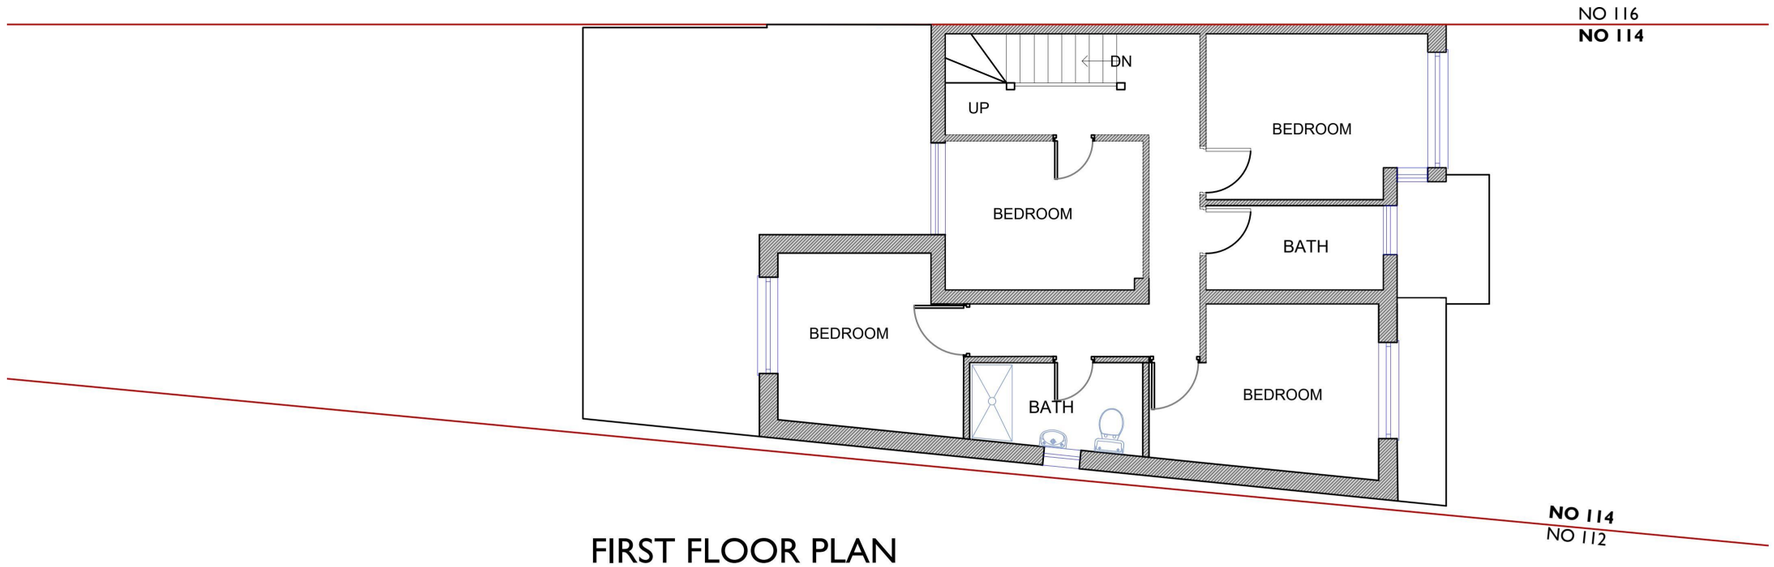


FIRST FLOOR PLAN
AS BUILT

0 1 2 3 4 5
Meters @ 1:100 @ A3


SCALE: 1:100	DATE: EFB 25
DRG NO: A 0102/02 Revision B	ISSUE:VARIATION OF CONDITION

DESCRIPTION-Variation of conditions no. 2 (Materials) and 3 (Approved Plans) of planning permission Ref: P0047.23 dated 15/03/2023 to regularise amendments to materials and internal and external layout (Retrospective) (Part single, part two storey front/side extension, part single, part two storey rear extension) at 114 Diban Avenue Hornchurch RM12 4YH

A R T T Z.ltd
Architectural Consultants

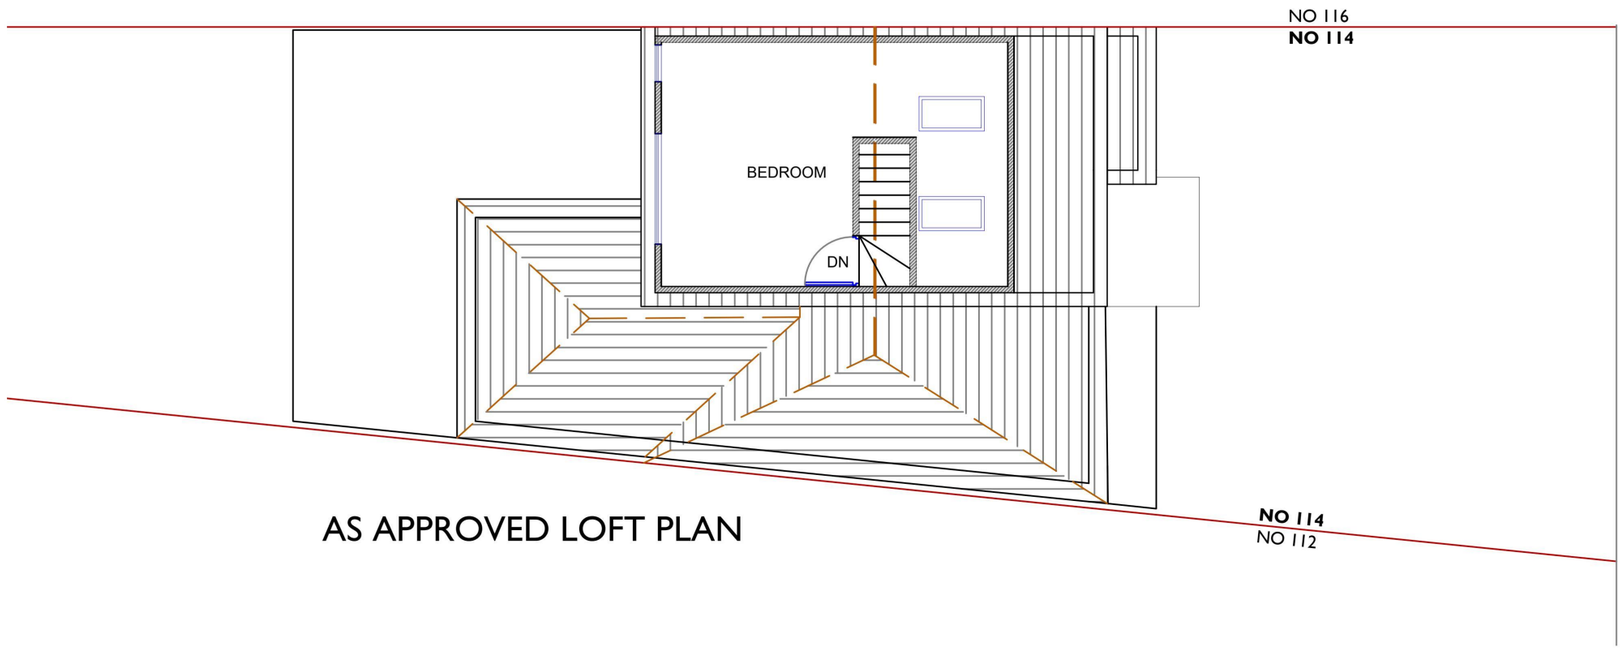

AS APPROVED LOFT PLAN

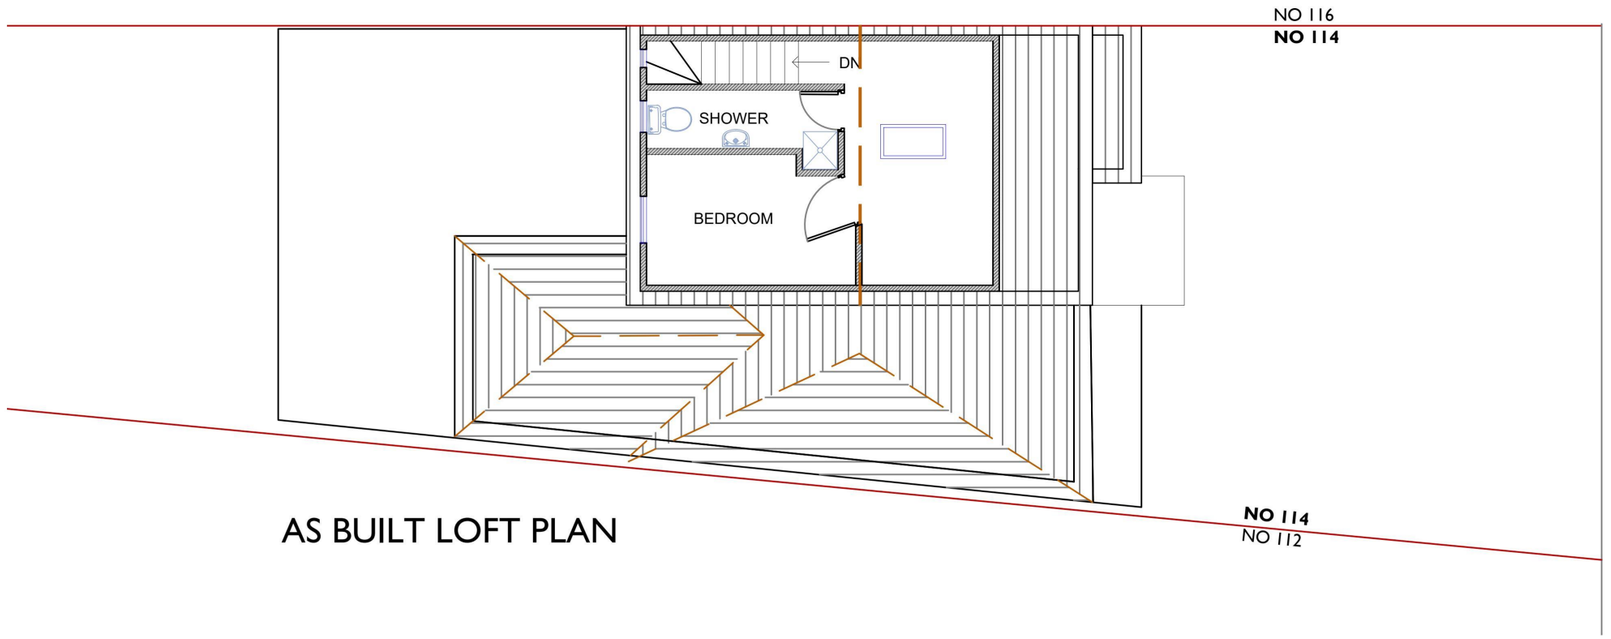

AS BUILT LOFT PLAN


0 1 2 3 4 5

Meters @ 1:100 @ A3


SCALE: 1:100	DATE: EFB 25
DRG NO: A 0102/03 Revision B	ISSUE:VARIATION OF CONDITION

DESCRIPTION-Variation of conditions no. 2 (Materials) and 3 (Approved Plans) of planning permission Ref: P0047.23 dated 15/03/2023 to regularise amendments to materials and internal and external layout (Retrospective) (Part single, part two storey front/side extension, part single, part two storey rear extension) at 114 Diban Avenue Hornchurch RM12 4YH


A R T T Z.ltd
Architectural Consultants

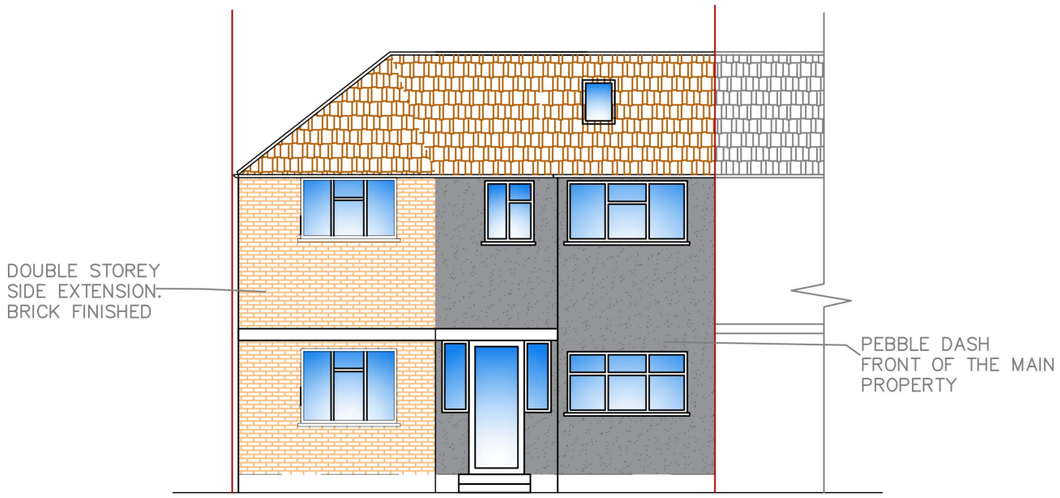


FRONT ELEVATION
AS BUILT/ PROPOSED

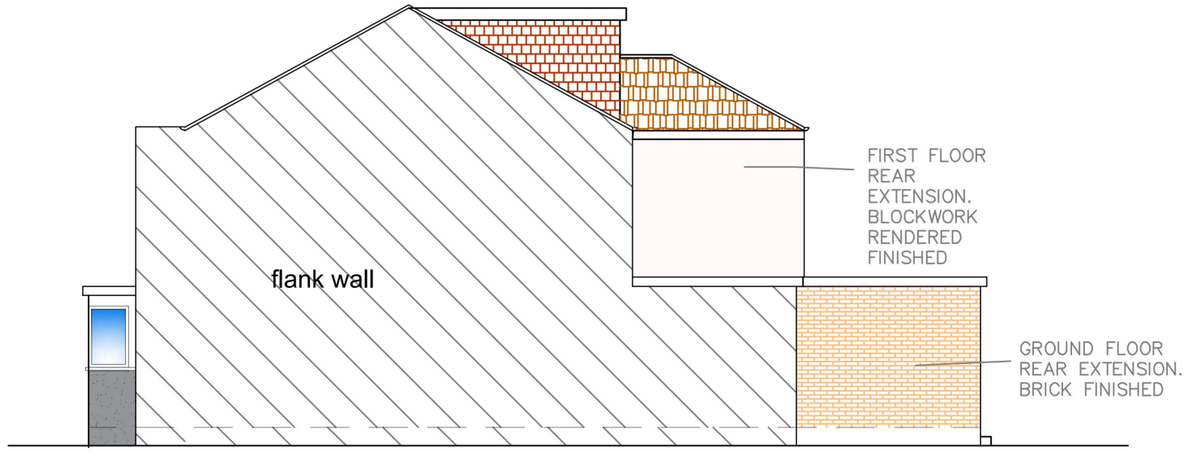


SIDE ELEVATION
AS BUILT/ PROPOSED

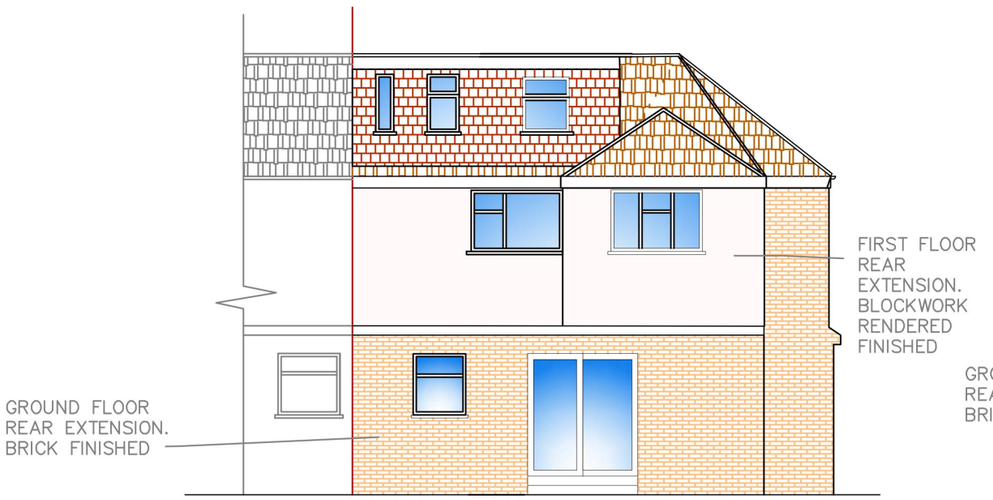

REAR ELEVATION
AS BUILT/ PROPOSED

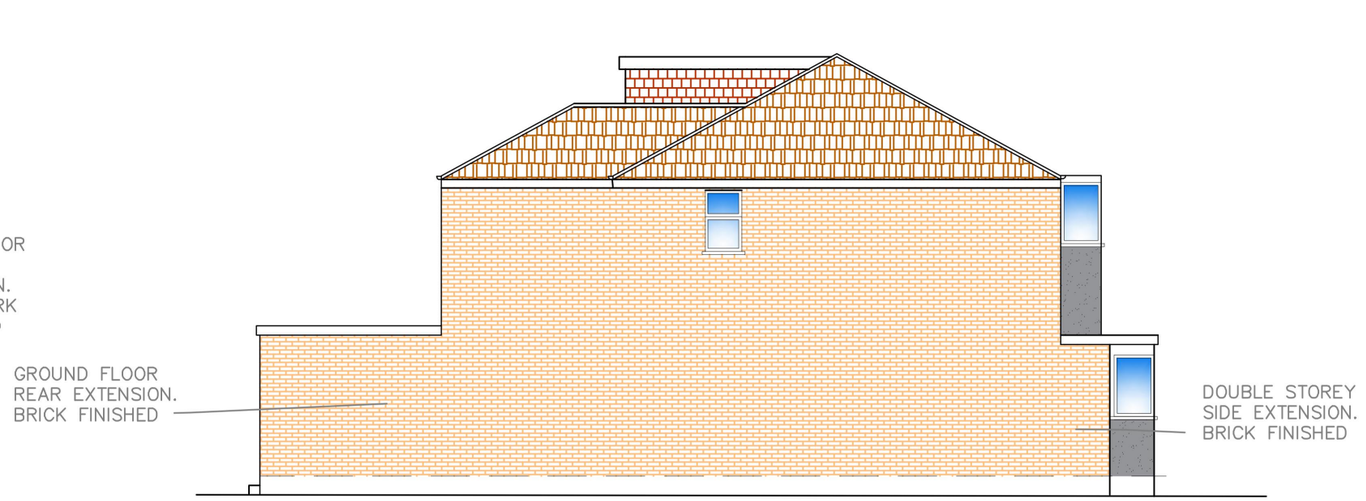


SIDE ELEVATION
AS BUILT/ PROPOSED

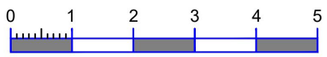


Meters @ 1:100 @ A3

SCALE: 1:100	DATE: NOV 26
DRG NO: A 0102/05 Revision C	ISSUE:VARIATION OF CONDITION


A R T T Z.ltd
Architectural Consultants

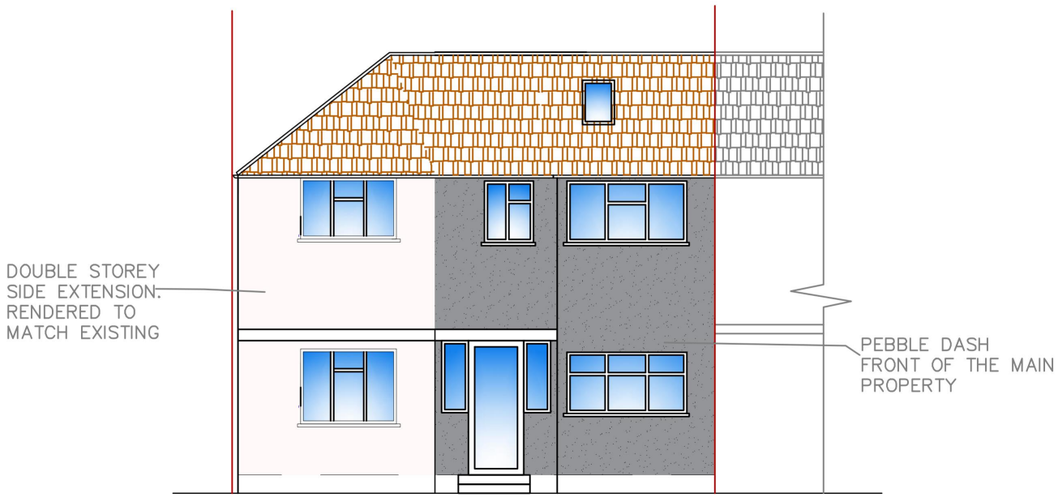


APPROVED FRONT ELEVATION
Ref: P0416.25

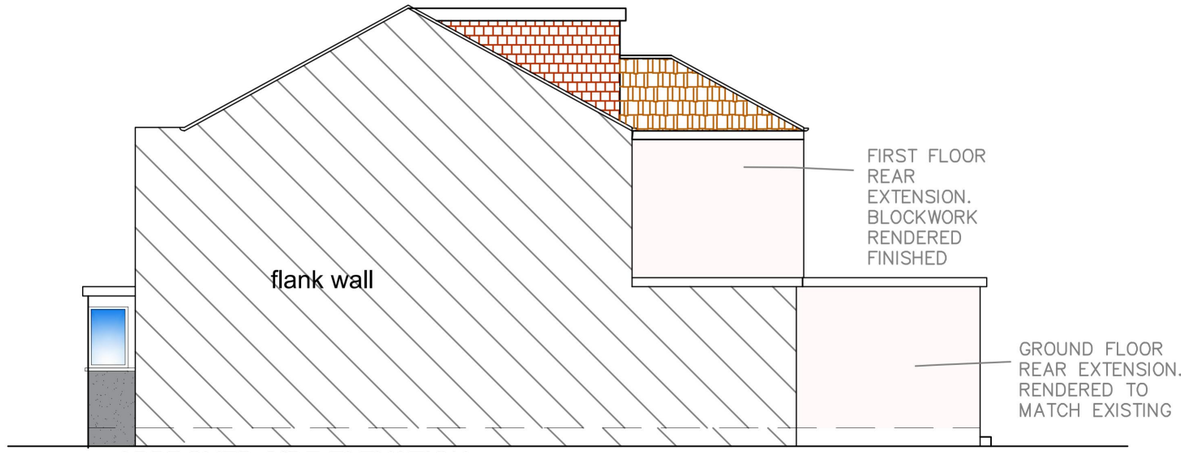


APPROVED SIDE ELEVATION
Ref: P0416.25

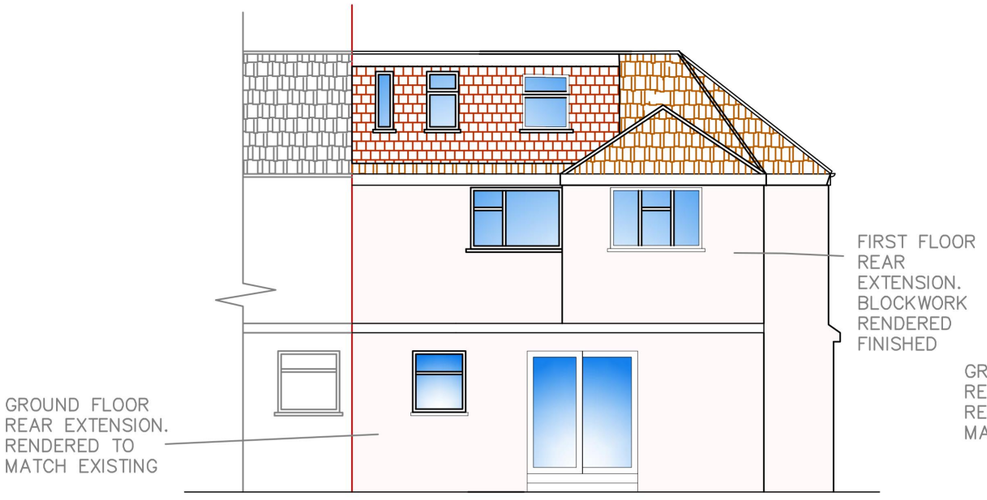

APPROVED REAR ELEVATION
Ref: P0416.25

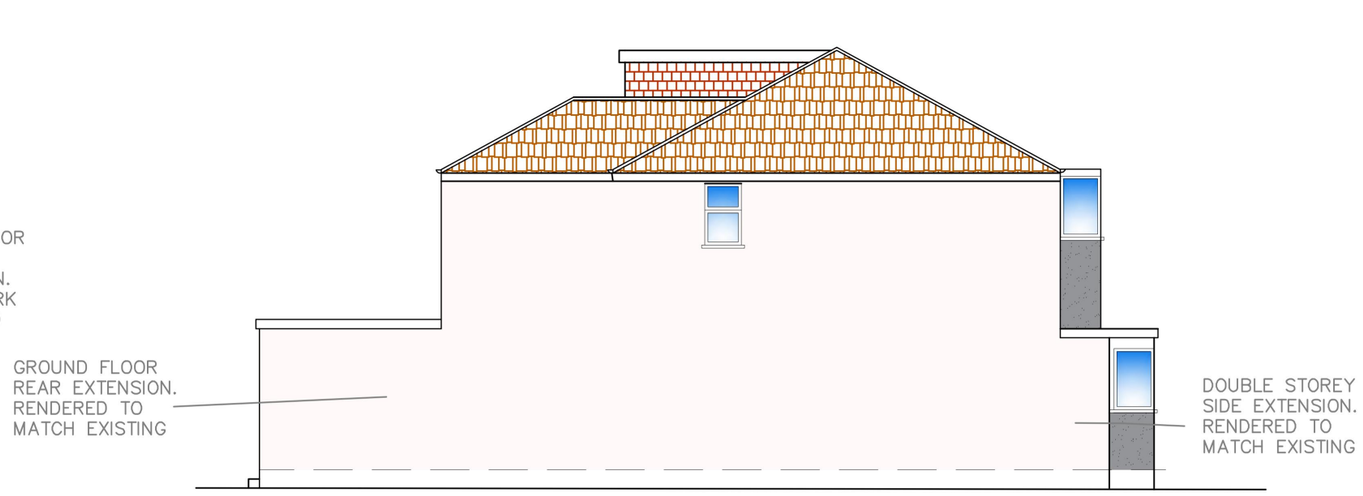

APPROVED SIDE ELEVATION
Ref: P0416.25

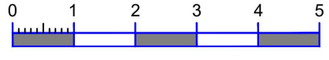

Meters @ 1:100 @ A3

SCALE: 1:100	DATE: NOV 26
DRG NO: A 0102/06 Revision B	ISSUE:VARIATION OF CONDITION

A R T T Z.ltd
Architectural Consultants



BLOCK/ROOF PLAN

SCALE:1/500

0 5 10 15 20 25 30 35 40 45 50

Meters @ 1:500 @ A3

N

SCALE: 1:500	DATE: EFB 25
DRG NO: A 0102/08 Revision B	ISSUE:VARIATION OF CONDITION

A R T T Z.ltd
Architectural Consultants